


STATE OF MINNESOTA )  
 ) ss.  
COUNTY OF OLMSTED )

Joseph J. Weichselbaum being duly sworn, says that he is a registered architect, that he has examined the attached set of floor plans marked Exhibits 1 and 2 of the building known as the HILLCREST PROFESSIONAL BUILDING, showing the location on the property, dimensions of the building and that the same is substantially an accurate, true and correct copy of the portion of the plans of the building as filed with and approved by the municipal and other governmental organizations having jurisdiction over the permits of construction of buildings within the City of Rochester, Minnesota and that said plans fully depict the layout, location and dimensions of the building as built.

By Joseph J. Weichselbaum  
Joseph J. Weichselbaum  
Minnesota Reg. No. 4784  
1903 South Broadway  
Rochester, Minnesota

Subscribed and sworn to before me  
this 30<sup>th</sup> day of June, 1978.

William E. ...  
Notary Public

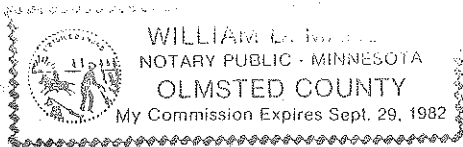

COUNTY RECORDER OFFICE } ss.  
Olmsted County, Minn.  
I hereby certify that the within instrument  
was filed in this office for record on

JUL 11 1978

at 3 o'clock P.  
Book F-4 of Misc. on page 535  
By Lois Finstuen County Recorder  
Barbara M. ... Deputy

Retain  
5<sup>th</sup>  
(Mahler)

ABSTRACT  
GRANTOR  
GRANTEE  
TRACKED  
PAID  
CHG: ✓

403475

403475

30<sup>th</sup>

X



