
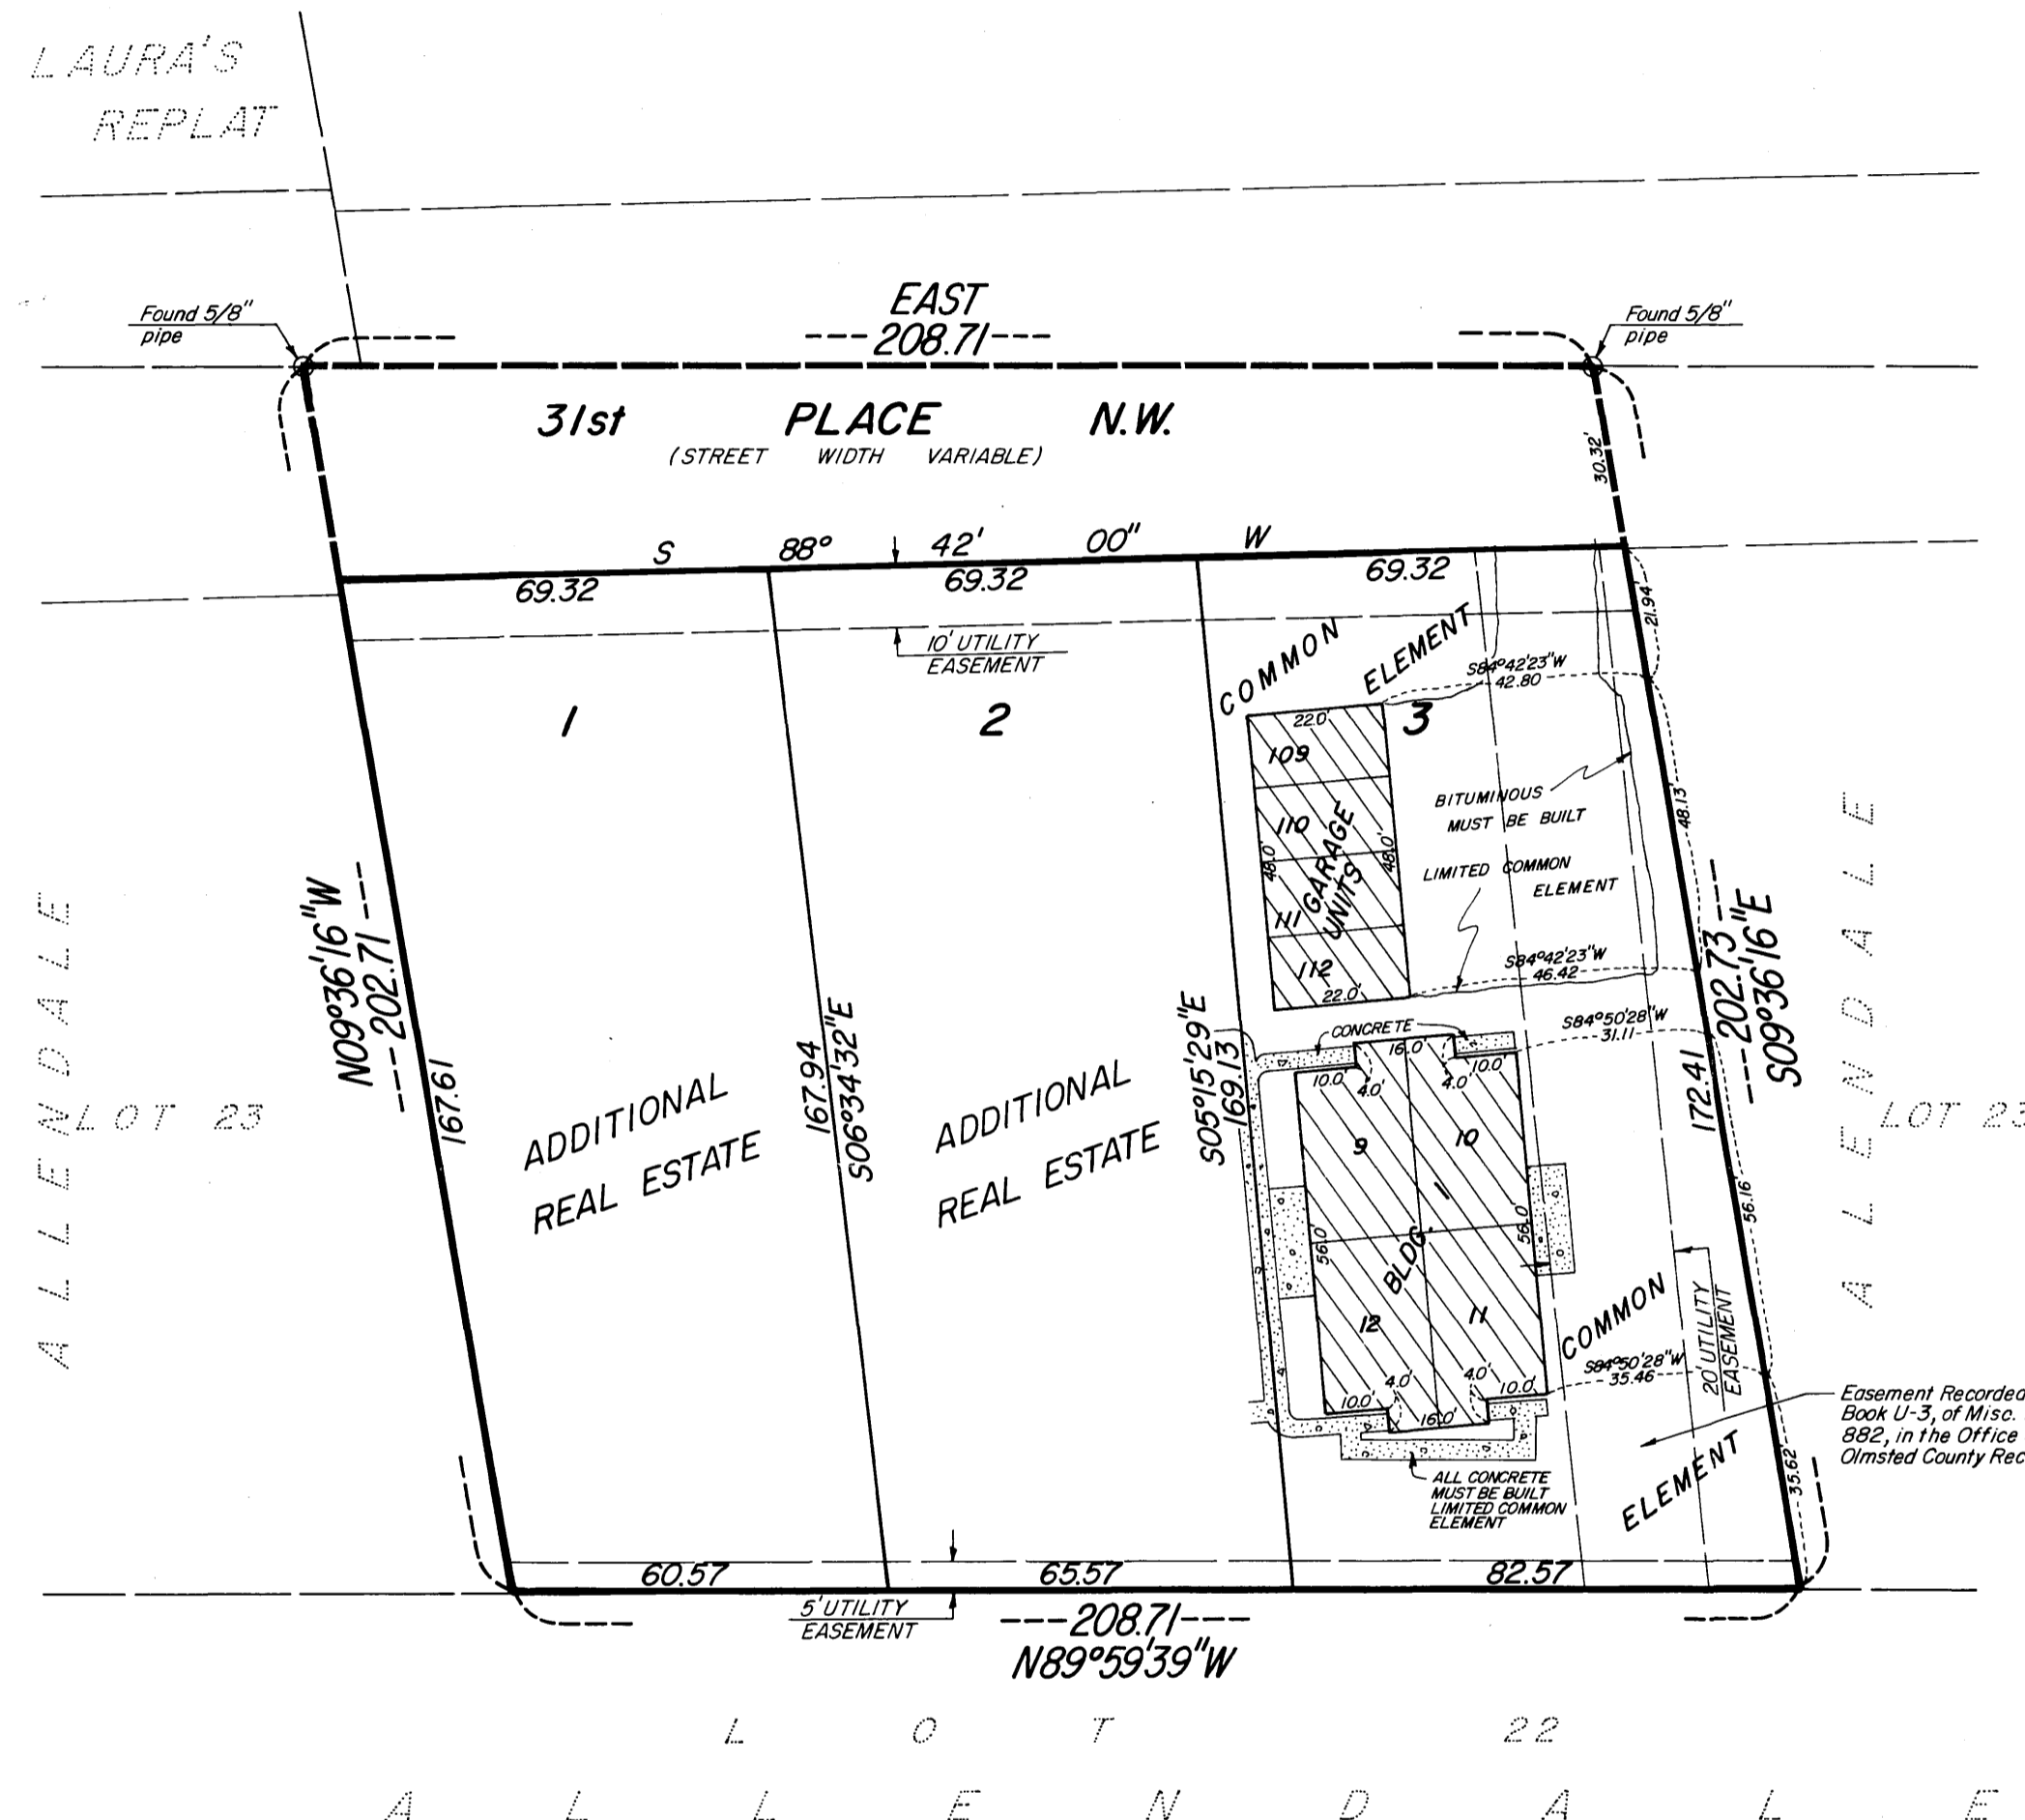


Office of Register of Deeds, State of Minnesota, Count of Olmsted. I hereby certify that the within ins't was filed in this office, for record on the 11 day of April A.D., 1986, at 2 o'clock P.M., and was duly recorded in Book V-4 of Misc on page 271.

LOIS FINSTUEN, Register of Deeds, Carol Ann Ferrie, deputy. Proved, Grantor, Grantee, Tracted, Pd., Chg., Mtg. Tax, Rev. Stamp, Deliver to, Address.

CONDOMINIUM NUMBER 103 HONEYWOOD CONDOMINIUM

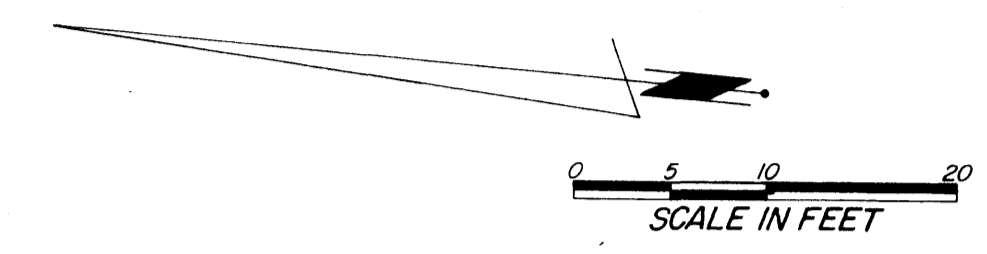

NOTE: ALL BEARINGS ASSUMED.



B.M. ELEV. 1053.39 TOP HYDRANT NUT ON NORTH SIDE 31st PLACE N.W. 300' EAST OF T.H. NO. 52 FRONTAGE ROAD

The undersigned, being first duly sworn under oath, certifies and deposes that the Site Plan of Condominium No. 103, HONEYWOOD CONDOMINIUM, being located upon the following described property: Lot 3, Block 1, HONEYWOOD, Rochester, Minnesota. and the additional real estate described as follows: Lot 1 & 2, Block 1, HONEYWOOD, Rochester, Minnesota. fully and accurately depicts all information required by Minnesota Statutes Section 515A.2-110. Dated this 14th day of March, 1986.

James E. Swanson, Registered Land Surveyor, Minnesota Registration No. 11622.

The foregoing instrument was acknowledged before me this 14th day of March, 1986, by James E. Swanson, a Registered Land Surveyor.

William E. Tointon, Notary Public, Olmsted County, Minnesota. My Commission Expires: WILLIAM E. TOINTON, NOTARY PUBLIC - MINNESOTA, OLMSTED COUNTY, MY COMM. EXP. AUG. 4, 1989.


Leon F. Mucha, a Registered Professional Engineer for the State of Minnesota pursuant to Minnesota Statutes Section 515A.2-101(b) does hereby certify that all structural components and mechanical systems serving more than one unit of all buildings containing or comprising any units hereby created are substantially completed consistent with the Floor Plans for Condominium No. 103, HONEYWOOD CONDOMINIUM.

Dated this 14th day of March, 1986.


Leon F. Mucha, Registered Professional Engineer, Minnesota Registration No. 14309.

The foregoing instrument was acknowledged before me this 14th day of March, 1986, by Leon F. Mucha, a Registered Professional Engineer.


William E. Tointon, Notary Public, Olmsted County, Minnesota. My Commission Expires: WILLIAM E. TOINTON, NOTARY PUBLIC - MINNESOTA, OLMSTED COUNTY, MY COMM. EXP. AUG. 4, 1989.

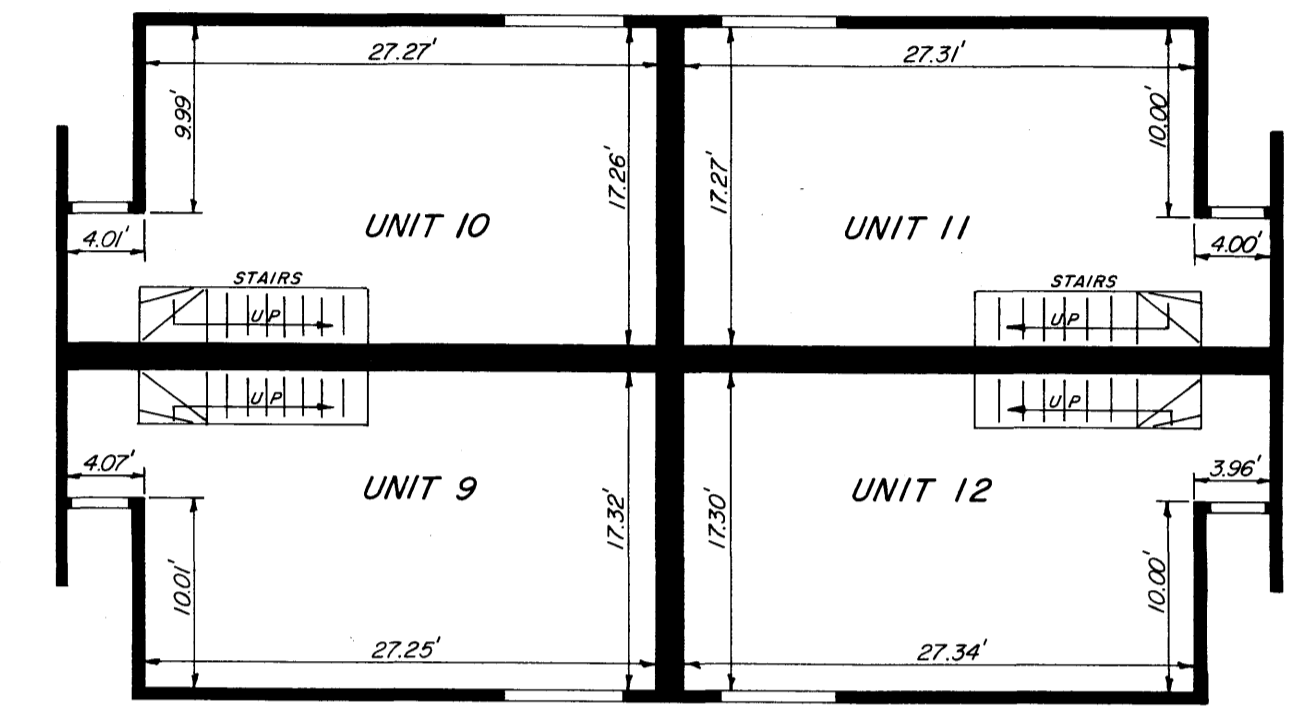

BUILDING 1 FIRST FLOOR PLAN. UNIT 9: FLOOR ELEVATION = 1051.26, FLOOR TO CEILING HEIGHT = 8.11'. UNIT 10: FLOOR ELEVATION = 1051.30, FLOOR TO CEILING HEIGHT = 8.11'. UNIT 11: FLOOR ELEVATION = 1051.31, FLOOR TO CEILING HEIGHT = 8.09'. UNIT 12: FLOOR ELEVATION = 1051.26, FLOOR TO CEILING HEIGHT = 8.12'.

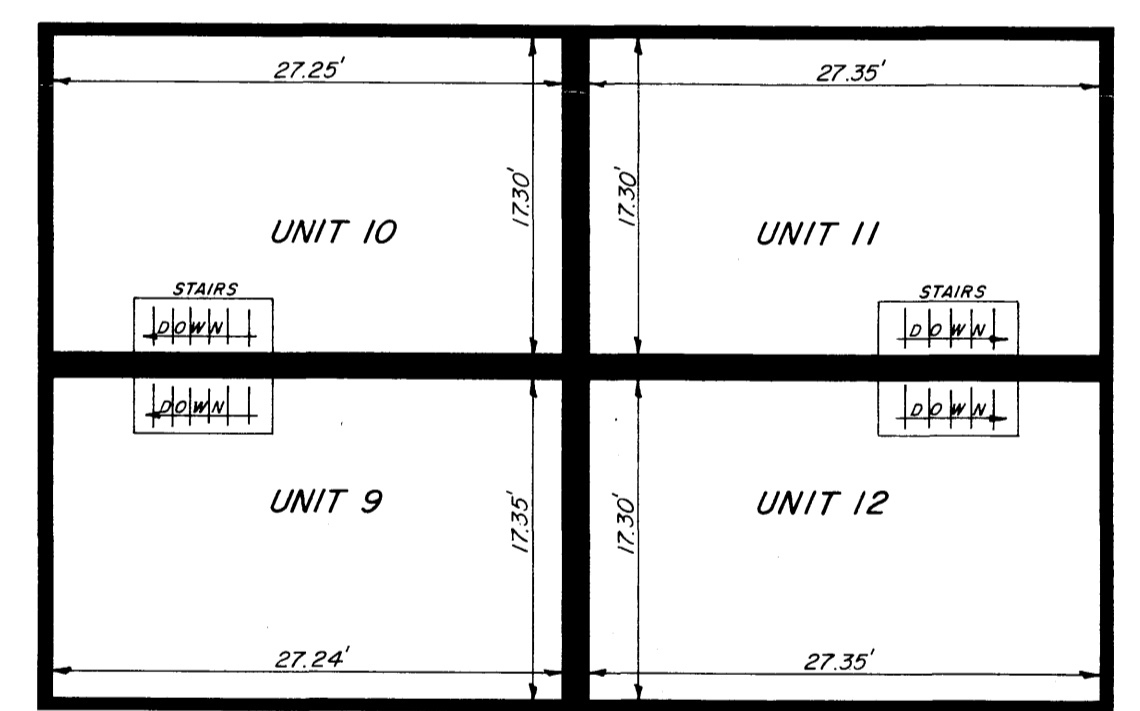

BUILDING 1 SECOND FLOOR PLAN. UNIT 9: FLOOR ELEVATION = 1060.37, FLOOR TO CEILING HEIGHT = 8.11'. UNIT 10: FLOOR ELEVATION = 1060.41, FLOOR TO CEILING HEIGHT = 8.12'. UNIT 11: FLOOR ELEVATION = 1060.41, FLOOR TO CEILING HEIGHT = 8.10'. UNIT 12: FLOOR ELEVATION = 1060.38, FLOOR TO CEILING HEIGHT = 8.11'.

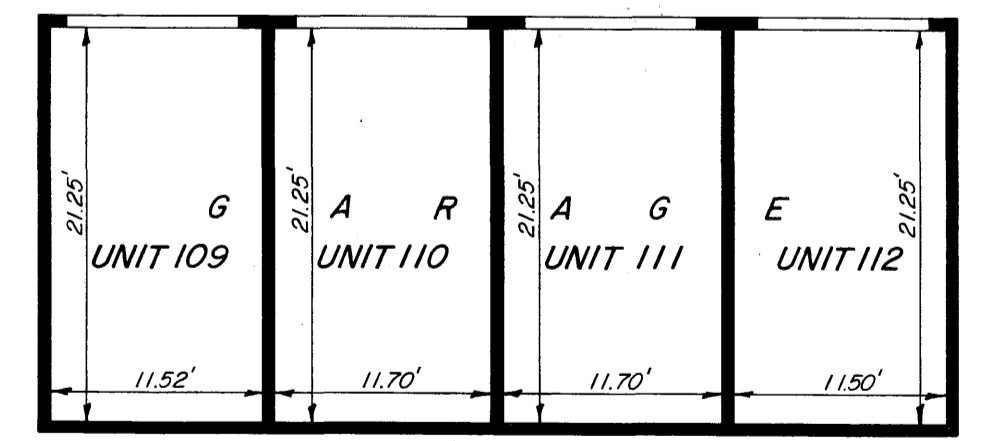

GARAGE UNITS. UNITS 109, 110, 111 & 112. FLOOR ELEVATION = 1049.19, FLOOR TO CEILING HEIGHT = 8.11'.

GARAGE FLOOR PLAN

Filed as Document No. on the day of A.D., 19, Olmsted County Recorder's Office.

PREPARED BY: MCGHIE & BETTS, INC. CONSULTING ENGINEERS, LAND SURVEYORS, ROCHESTER, MINNESOTA.

Office of County Recorder,
State of Minnesota
County of Olmsted

I hereby certify that the within inst.
was filed in this office, for record on the
7 day of Nov A.D., 1986, at
11 o'clock A. M., and was duly
recorded in Book W.4 of Min
on page 699.


LOIS FINSTUEN
County Recorder
Proved Carol M. Ferris deputy
Grantor
Grantee
Tracted
Pd.
Chg.

Deliver to Retain
Address

CPI 1M 3/86

CONDOMINIUM NUMBER 103


HONEYWOOD CONDOMINIUM PLAT FIRST SUPPLEMENTAL SITE AND FLOOR PLAN

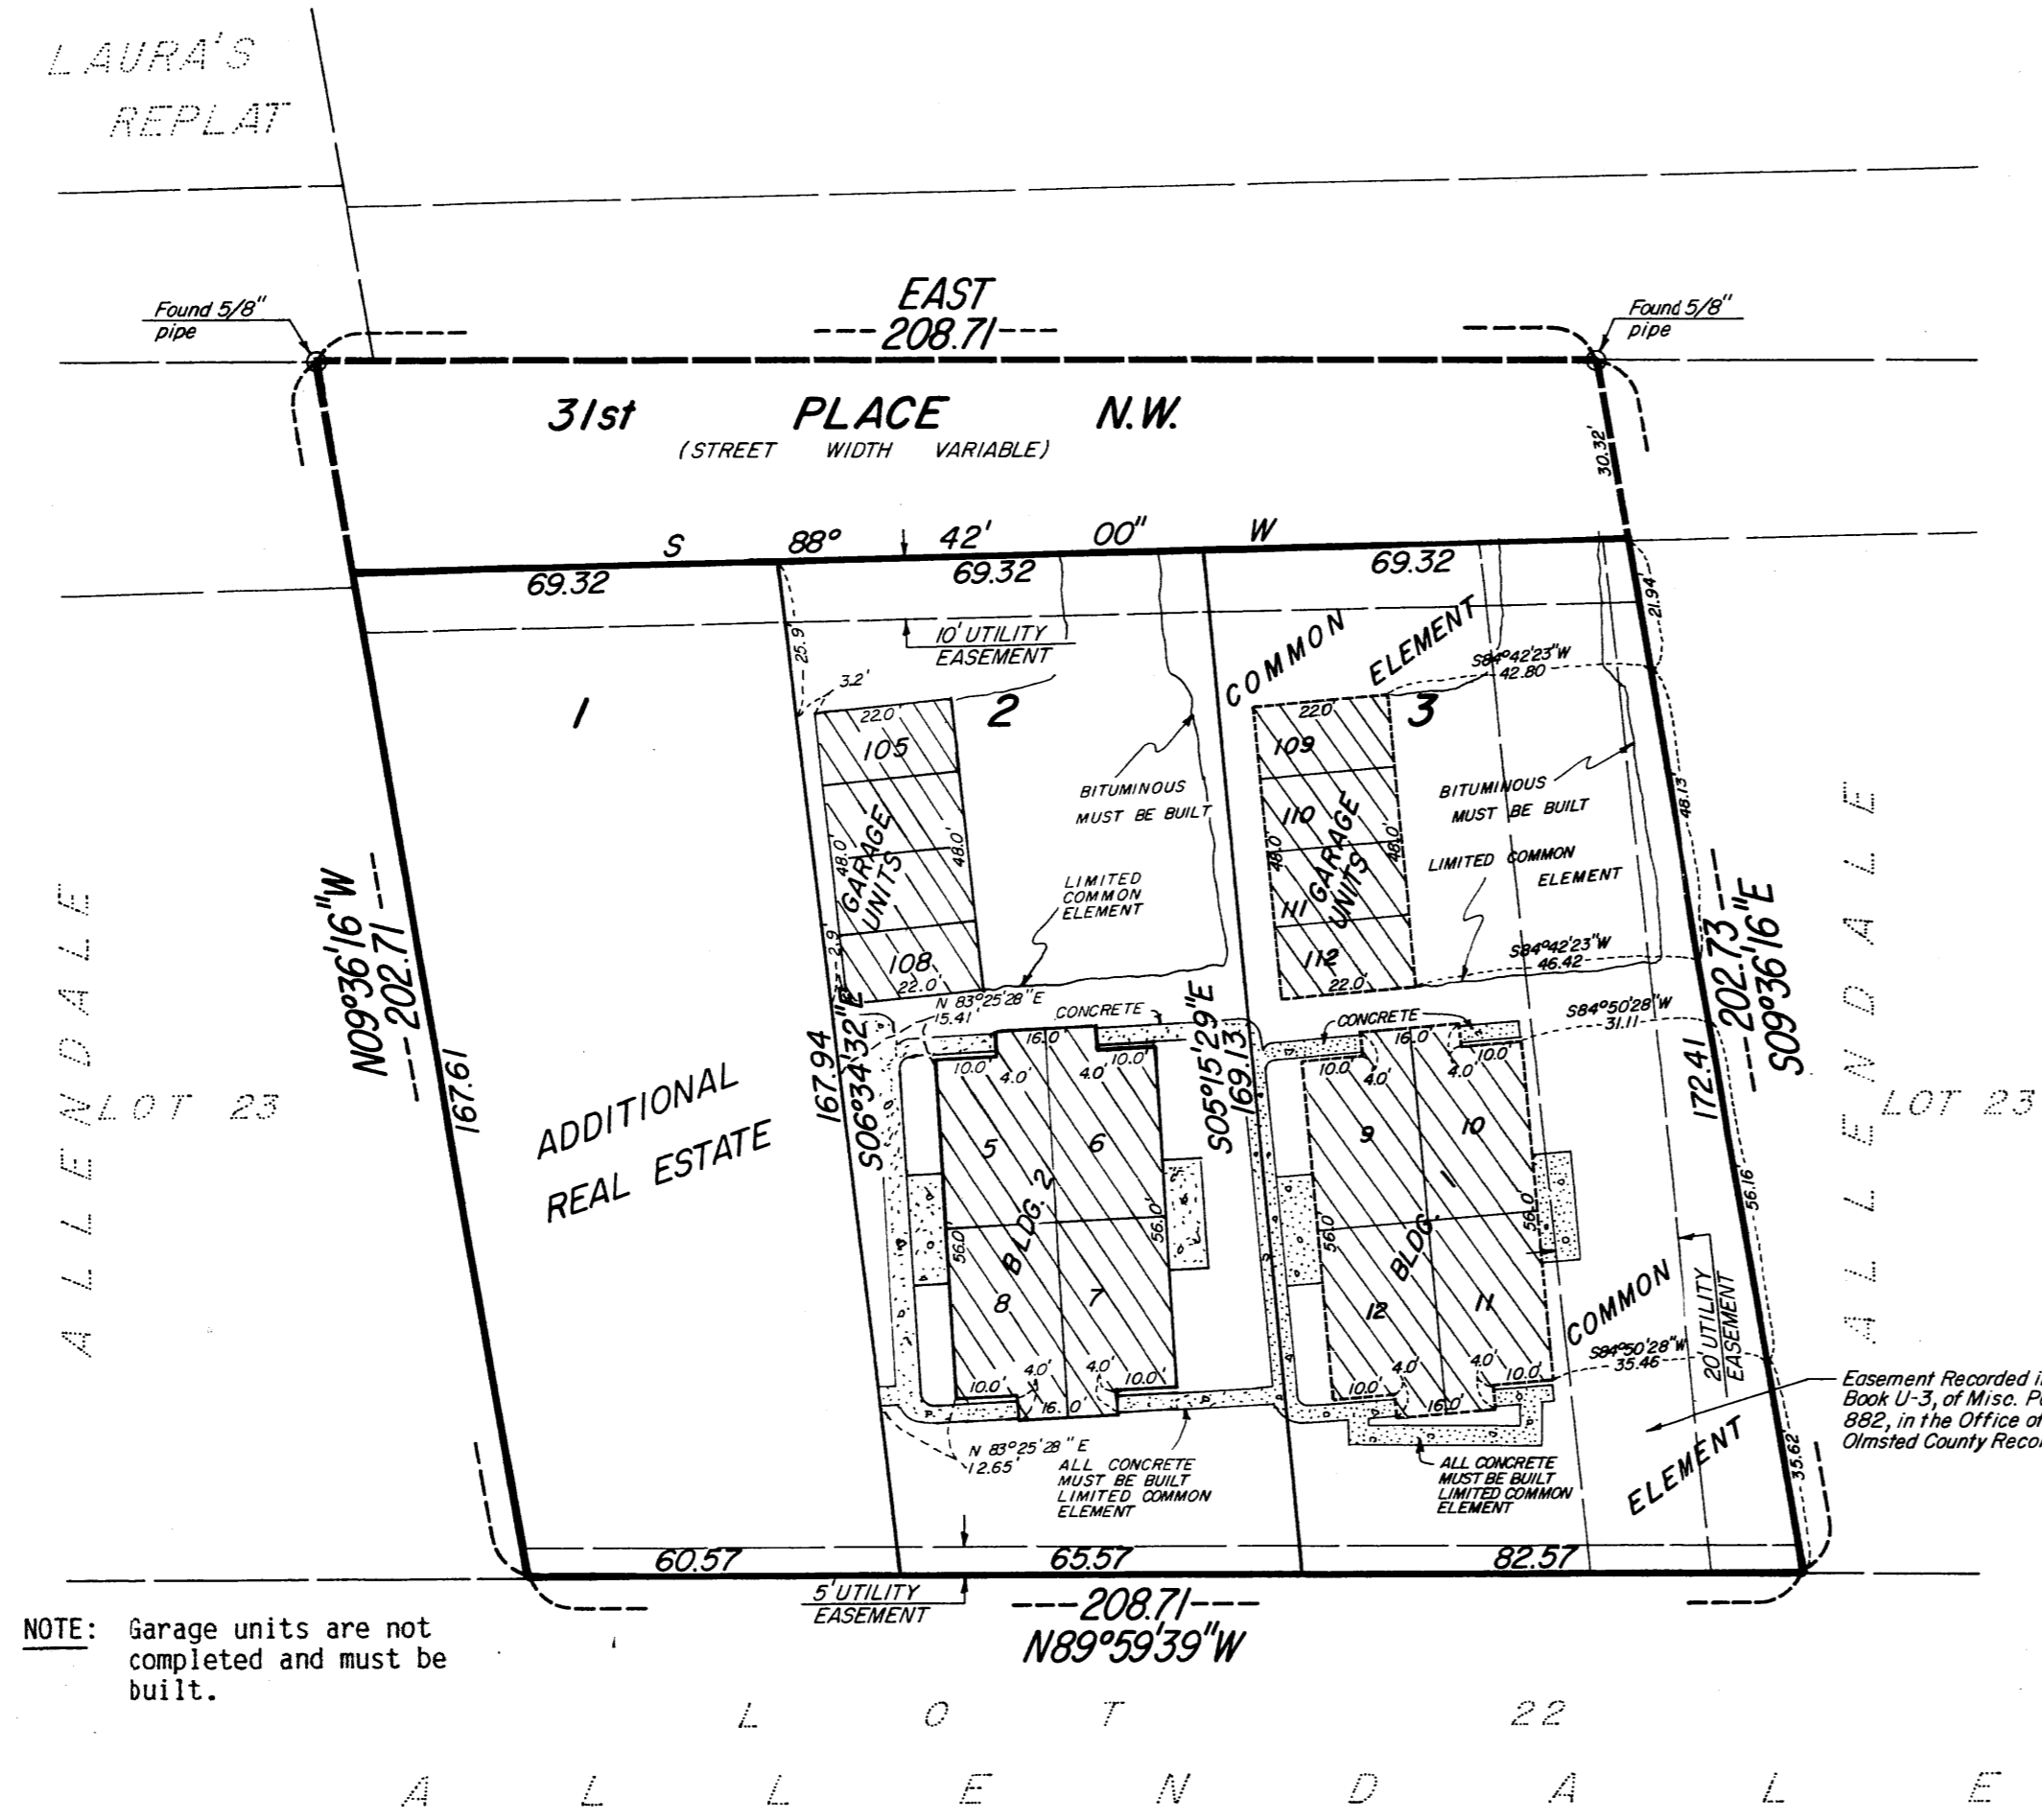


NOTE: Garage units are not completed and must be built.

NOTE: For Building 1, see original floor plans.

NOTE: ALL BEARINGS ASSUMED.

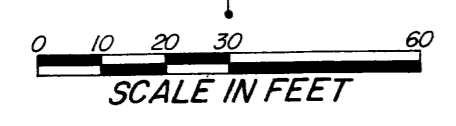


SITE PLAN

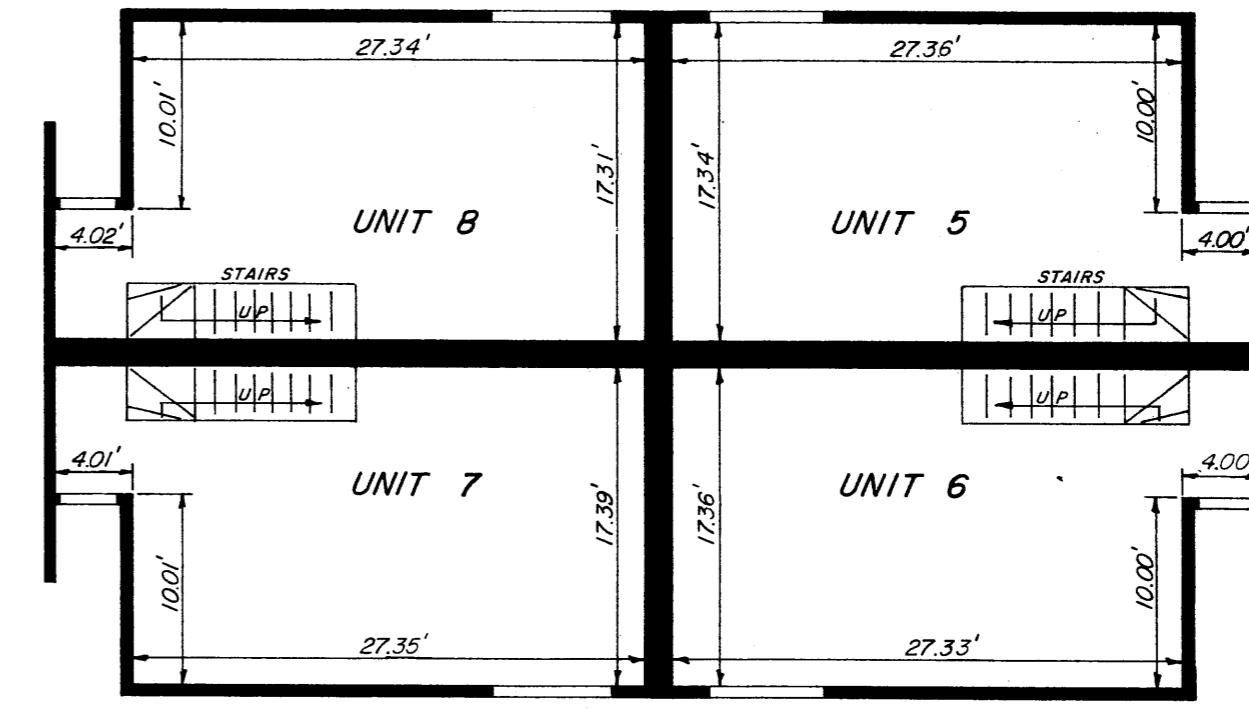

FIRST FLOOR PLAN

BUILDING 2
FIRST FLOOR PLAN


- UNIT 7
FLOOR ELEVATION = 1052.32
FLOOR TO CEILING HEIGHT = 8.12'
- UNIT 8
FLOOR ELEVATION = 1052.32
FLOOR TO CEILING HEIGHT = 8.12'
- UNIT 5
FLOOR ELEVATION = 1052.32
FLOOR TO CEILING HEIGHT = 8.12'
- UNIT 6
FLOOR ELEVATION = 1052.32
FLOOR TO CEILING HEIGHT = 8.12'

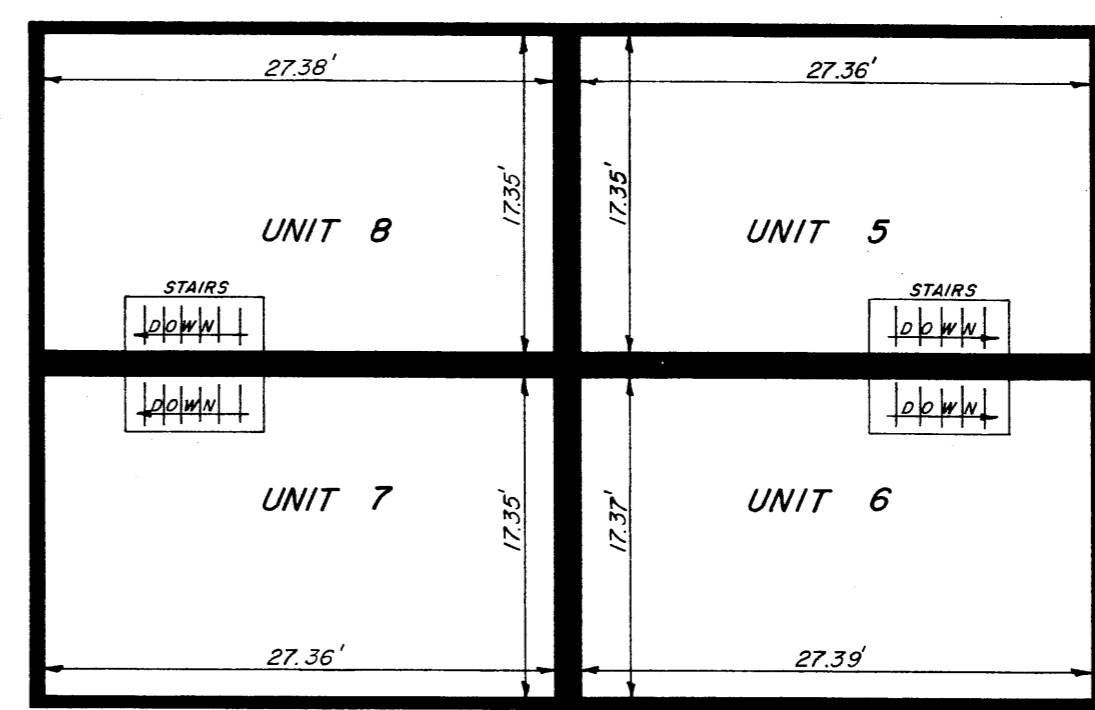

SECOND FLOOR PLAN

BUILDING 2
SECOND FLOOR PLAN

- UNIT 7
FLOOR ELEVATION = 1061.42
FLOOR TO CEILING HEIGHT = 8.10'
- UNIT 8
FLOOR ELEVATION = 1061.42
FLOOR TO CEILING HEIGHT = 8.10'
- UNIT 5
FLOOR ELEVATION = 1061.42
FLOOR TO CEILING HEIGHT = 8.10'
- UNIT 6
FLOOR ELEVATION = 1061.42
FLOOR TO CEILING HEIGHT = 8.10'

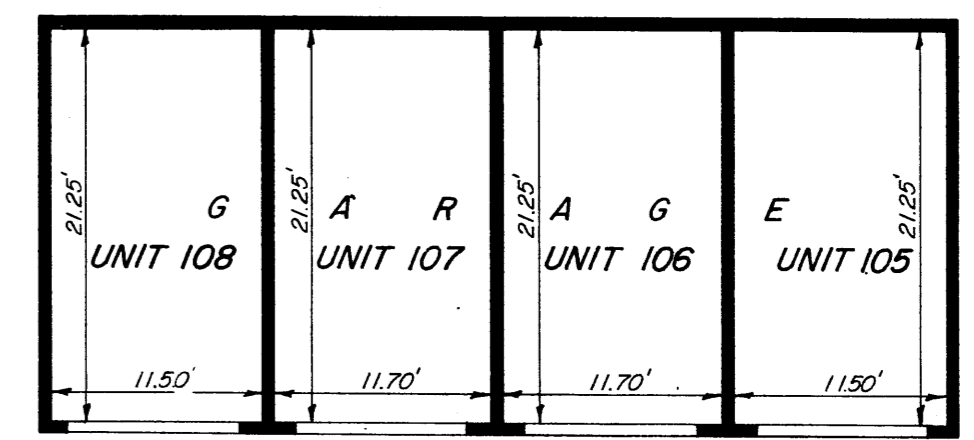

GARAGE FLOOR PLAN

GARAGE UNITS

UNITS 105, 106, 107 & 108
FLOOR ELEVATION = 1050.84

B.M. ELEV. 1053.39
TOP HYDRANT NUT ON NORTH
SIDE 31st PLACE N.W. + 300'
EAST OF T.H. NO. 52
FRONTAGE ROAD

The undersigned, being first duly sworn under oath, certifies and deposes that the Site and Floor Plan of Condominium No. 103, HONEYWOOD CONDOMINIUM PLAT, FIRST SUPPLEMENTAL SITE AND FLOOR PLAN, being located upon the following described property:

Lot 2, Block 1, HONEYWOOD, Rochester, Minnesota

fully and accurately depicts all information required by Minnesota Statutes Section 515A.2-110. Dated this 3rd day of October, 1986.

James E. Swanson
James E. Swanson
Registered Land Surveyor
Minnesota Registration No. 11622

State of Minnesota
County of Olmsted

The foregoing instrument was acknowledged before me this 3rd day of October, 1986, by James E. Swanson, a Registered Land Surveyor.

William E. Tomlin
Notary Public, Olmsted County, Minnesota
MY COMMISSION EXPIRES: AUG. 4, 1989

Leon F. Mucha, a Registered Professional Engineer for the State of Minnesota pursuant to Minnesota Statutes Section 515A.2-101(b) does hereby certify that all structural components and mechanical systems serving more than one unit of all buildings containing or comprising any units hereby created are substantially completed consistent with the Site and Floor Plans for Condominium No. 103, HONEYWOOD CONDOMINIUM PLAT, FIRST SUPPLEMENTAL SITE AND FLOOR PLAN.

Dated this 3rd day of OCTOBER, 1986.

Leon F. Mucha
Leon F. Mucha
Registered Professional Engineer
Minnesota Registration No. 14309

State of Minnesota
County of Olmsted

The foregoing instrument was acknowledged before me this 3rd day of OCTOBER, 1986, by Leon F. Mucha, a Registered Professional Engineer.

William E. Tomlin
Notary Public, Olmsted County, Minnesota
MY COMMISSION EXPIRES: AUG. 4, 1989


Filed as Document No. _____
on the _____
day of _____
A.D., 19____, Olmsted
County Recorder's Office.

PREPARED BY:
McGHEE & BETTS, INC.
CONSULTING ENGINEERS
LAND SURVEYORS
ROCHESTER, MINNESOTA

FILE NO. 86-07E

CONDOMINIUM NUMBER 103


HONEYWOOD CONDOMINIUM PLAT
SECOND SUPPLEMENTAL SITE AND FLOOR PLAN

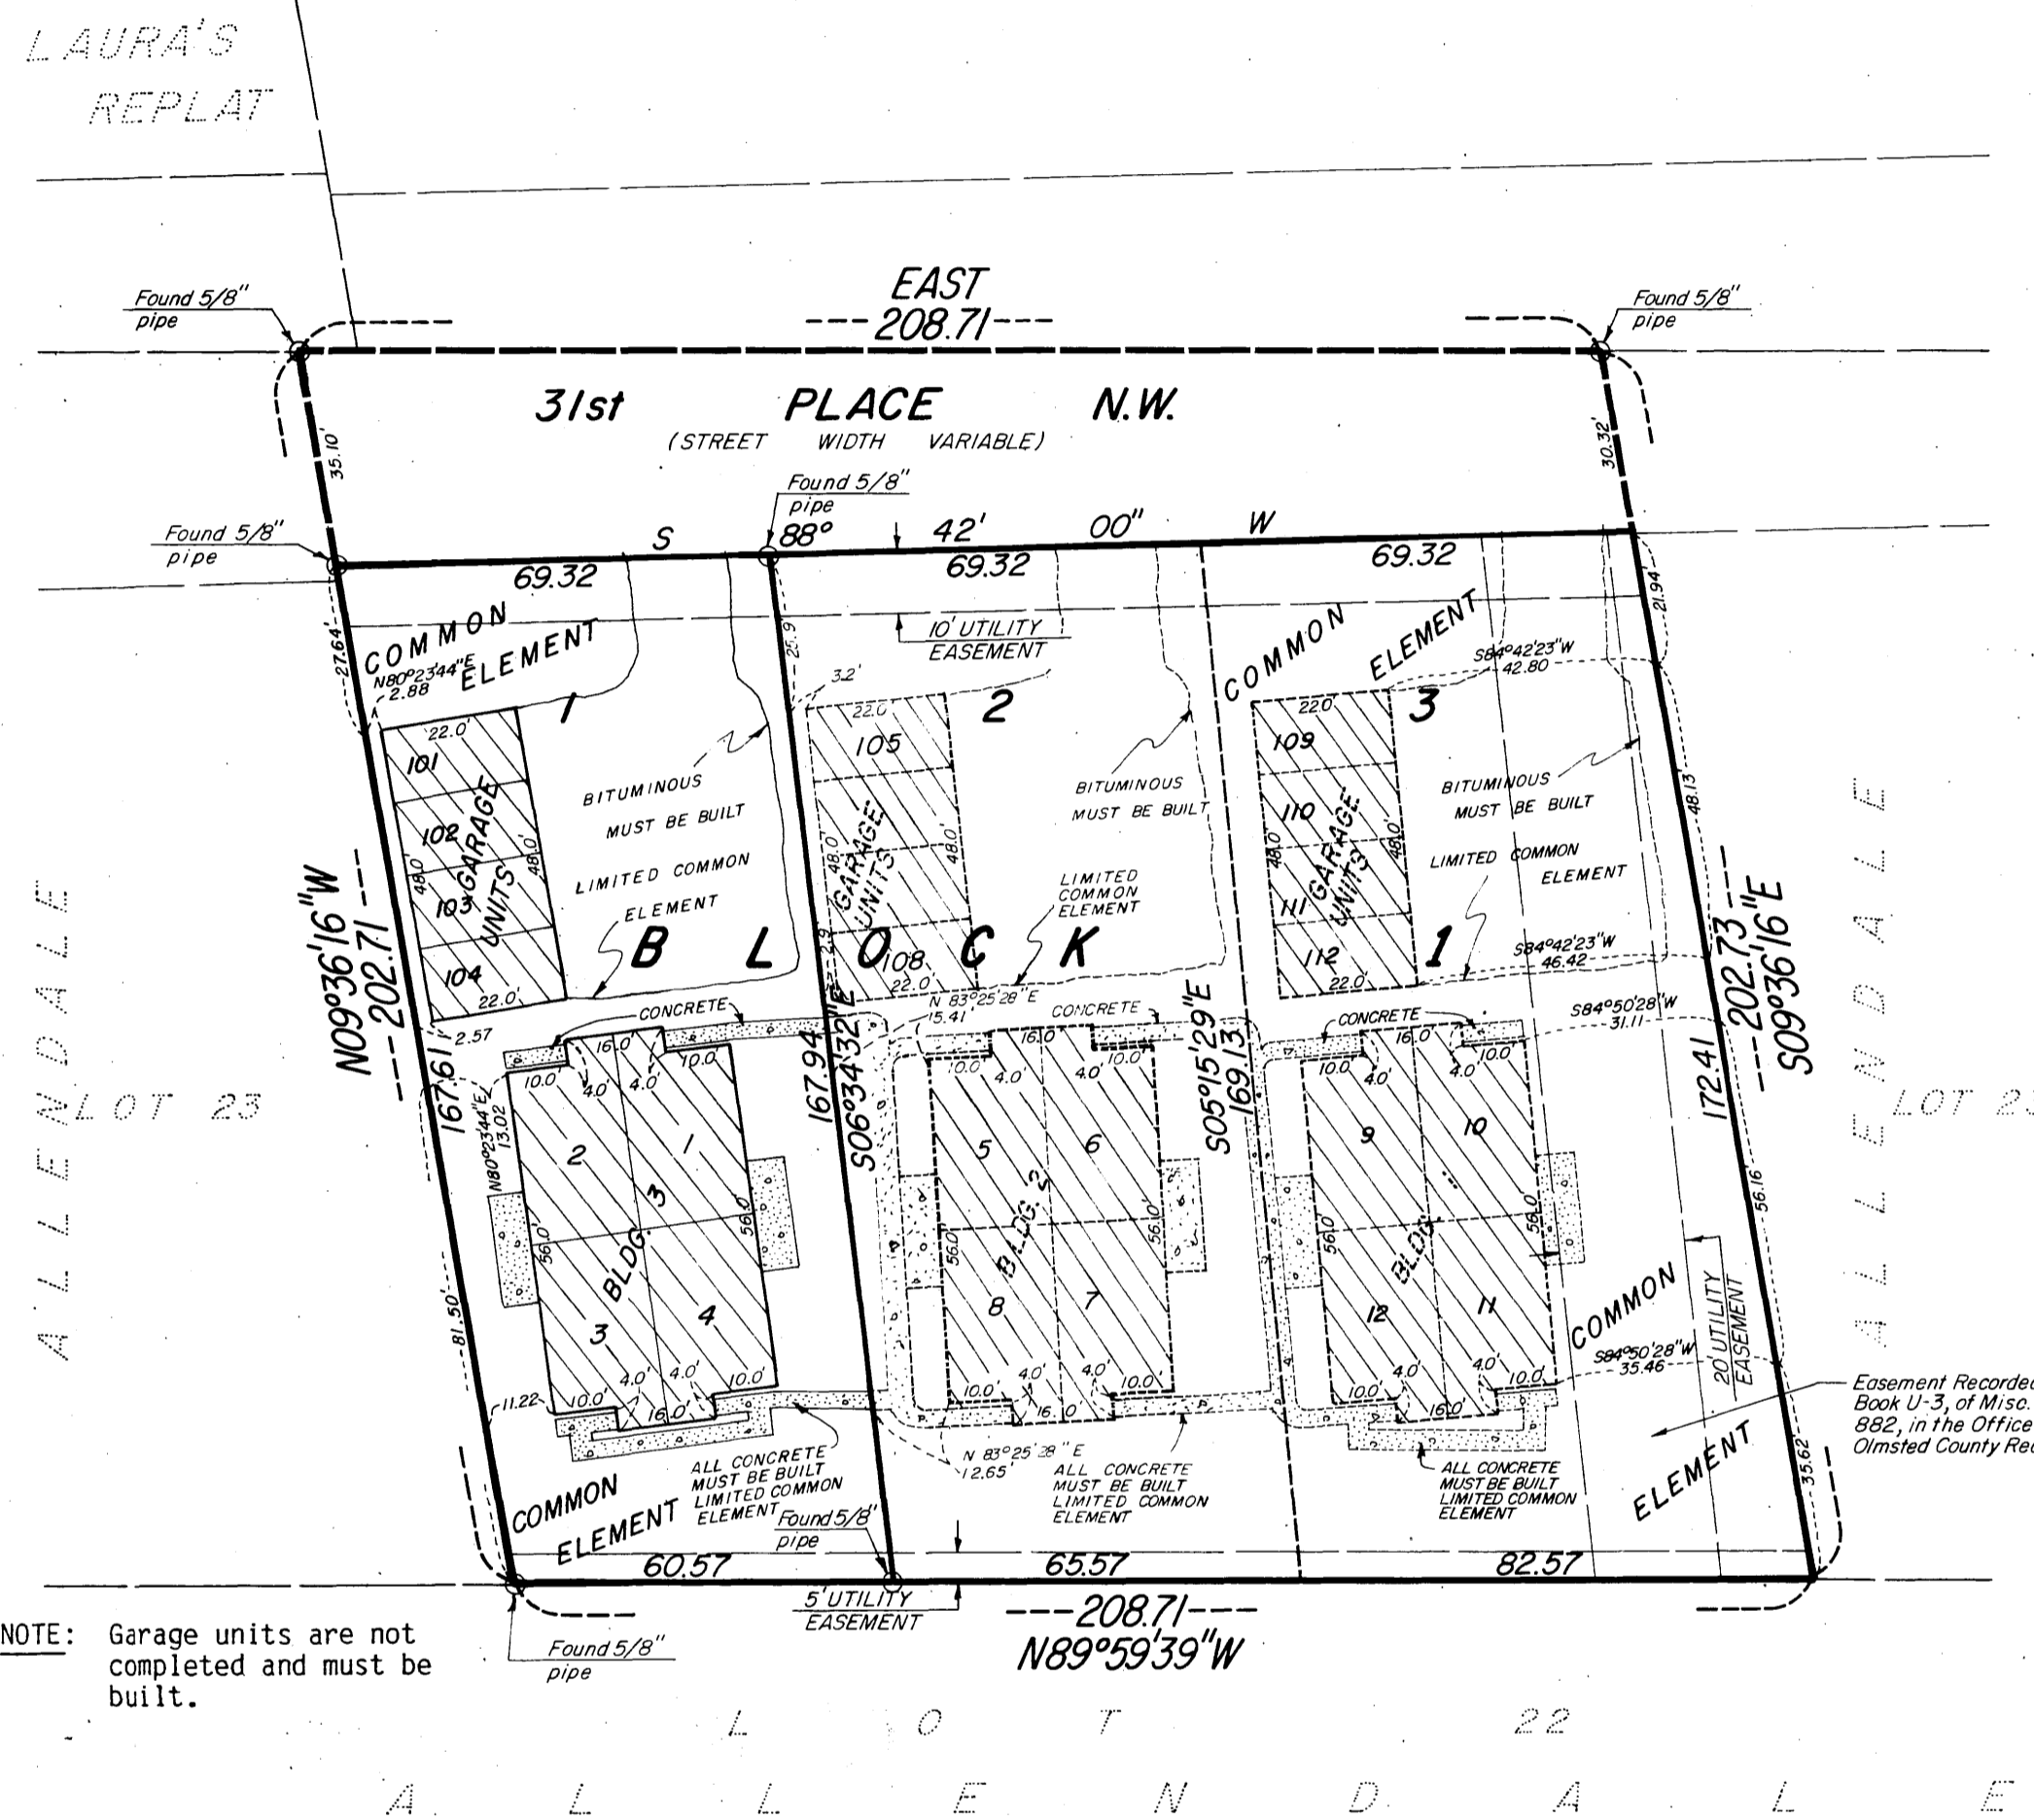

NOTE: Garage units are not completed and must be built.

NOTE: ALL BEARINGS ARE IN RELATIONSHIP WITH THE SOUTH LINE OF HONEYWOOD, WHICH IS ASSUMED TO BE N89°59'39"W.

SITE PLAN

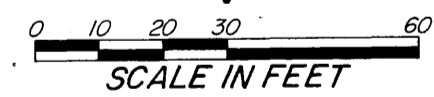

B.M. ELEV. 1053.39
TOP OF HYDRANT NUT ON NORTH SIDE 31st PLACE N.W. ± 300 EAST OF T.H. NO. 52 FRONTAGE ROAD

The undersigned, being first duly sworn under oath, certifies and deposes that this CONDOMINIUM NO. 103, HONEYWOOD CONDOMINIUM PLAT, SECOND SUPPLEMENTAL SITE AND FLOOR PLAN, being located upon the following described property:

Lot 1, Block 1, HONEYWOOD, Rochester, Minnesota
fully and accurately depicts all information required by Minnesota Statutes Section 515A.2-110. Dated this 12th day of May, 1987.

James E. Swanson
James E. Swanson
Registered Land Surveyor
Minnesota Registration No. 11622

State of Minnesota
County of Olmsted

The foregoing instrument was acknowledged before me this 12th day of May, 1987, by James E. Swanson, a Registered Land Surveyor.

William E. Tointon
Notary Public, Olmsted County, Minnesota

My Commission Expires:

County Surveyor


I hereby certify that this Condominium Plat has been checked and recommended for approval this 12th day of May, 1987.

Reginald W. Brand
County Surveyor

Filed as Document No. 531897 on the 7 day of Aug., 1987, Olmsted County Recorder's Office.

PREPARED BY:
MCGHIE & BETTS, INC.
CONSULTING ENGINEERS
LAND SURVEYORS
ROCHESTER, MINNESOTA


BUILDING 3 FIRST FLOOR PLAN

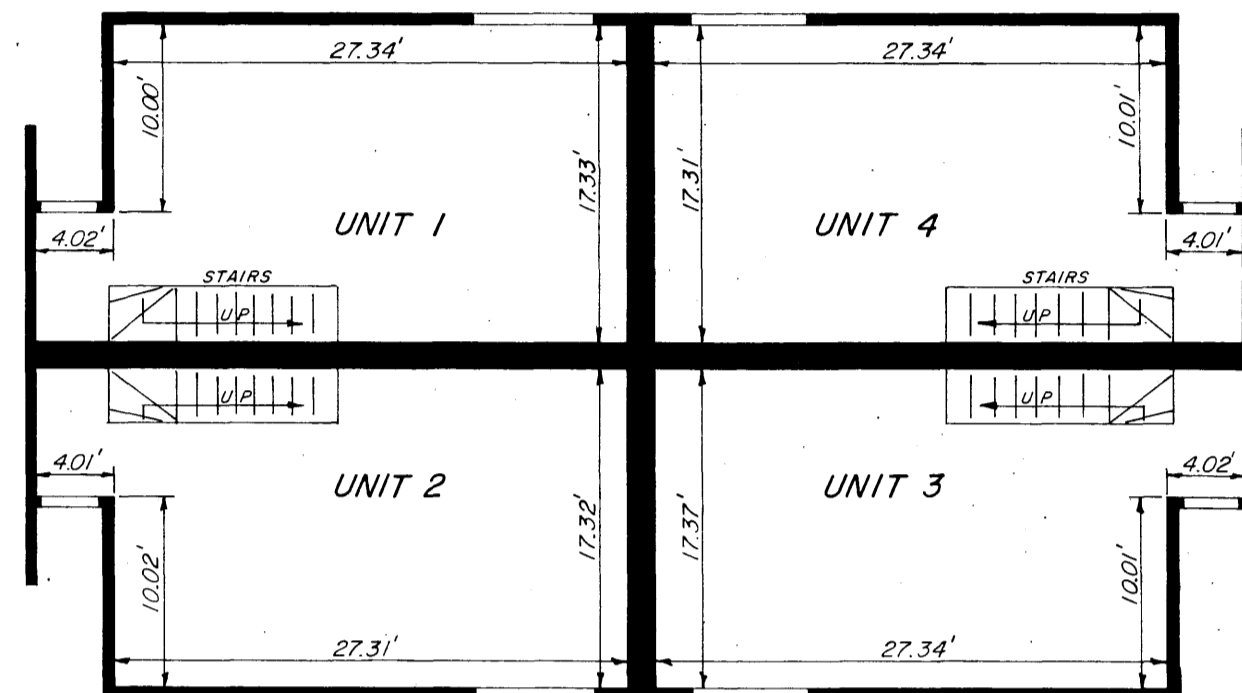

UNIT 2
FLOOR ELEVATION = 1053.49
FLOOR TO CEILING HEIGHT = 8.10'
UNIT 1
FLOOR ELEVATION = 1053.52
FLOOR TO CEILING HEIGHT = 8.11'
UNIT 4
FLOOR ELEVATION = 1053.53
FLOOR TO CEILING HEIGHT = 8.10'
UNIT 3
FLOOR ELEVATION = 1053.49
FLOOR TO CEILING HEIGHT = 8.08'

FIRST FLOOR PLAN


BUILDING 3 SECOND FLOOR PLAN

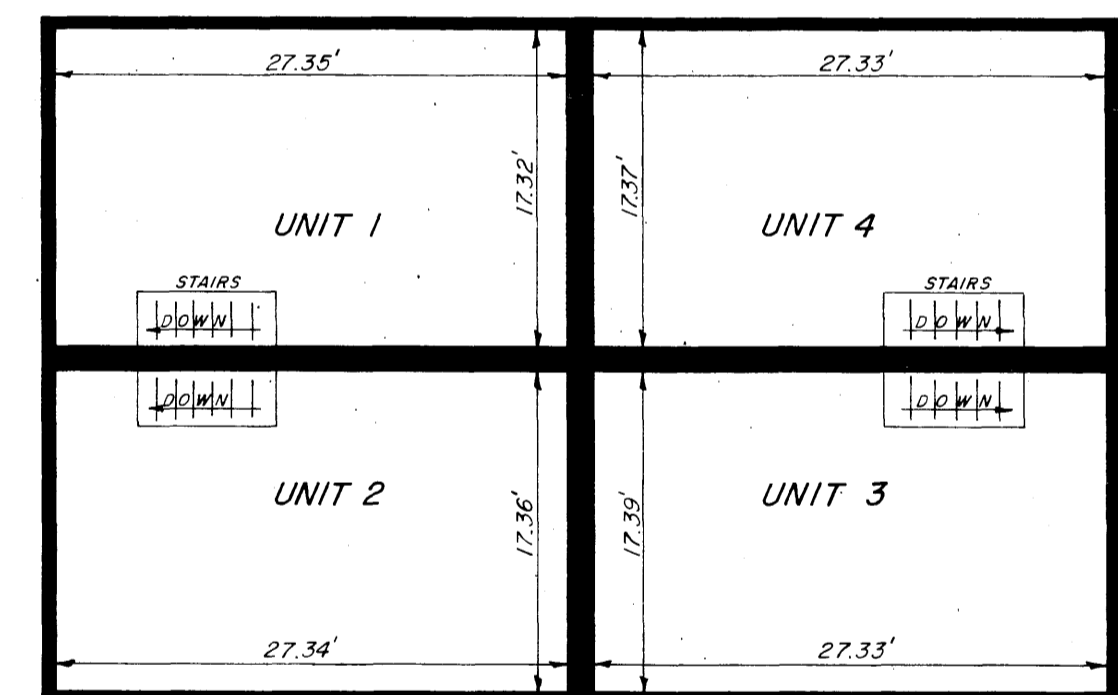

UNIT 2
FLOOR ELEVATION = 1062.59
FLOOR TO CEILING HEIGHT = 8.11'
UNIT 1
FLOOR ELEVATION = 1062.63
FLOOR TO CEILING HEIGHT = 8.11'
UNIT 4
FLOOR ELEVATION = 1062.63
FLOOR TO CEILING HEIGHT = 8.11'
UNIT 3
FLOOR ELEVATION = 1062.63
FLOOR TO CEILING HEIGHT = 8.10'

SECOND FLOOR PLAN

GARAGE UNITS

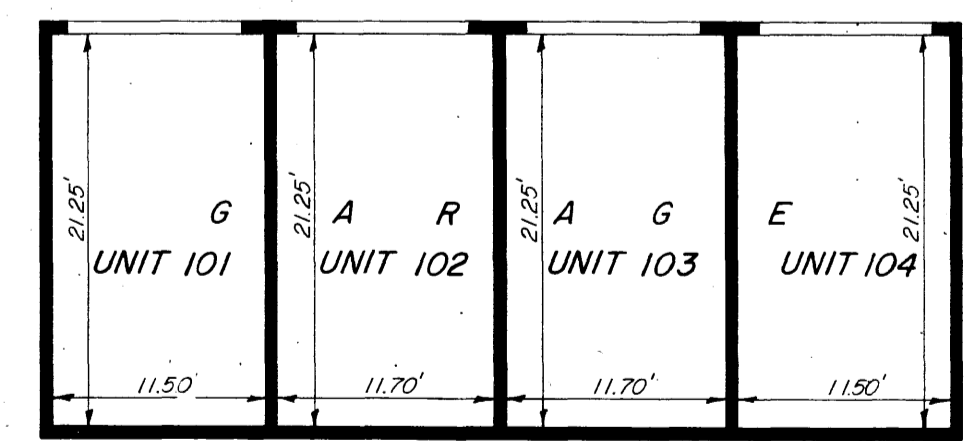

UNITS 101, 102, 103 & 104
FLOOR ELEVATION = 1053.30

GARAGE FLOOR PLAN