


# EYOTA.

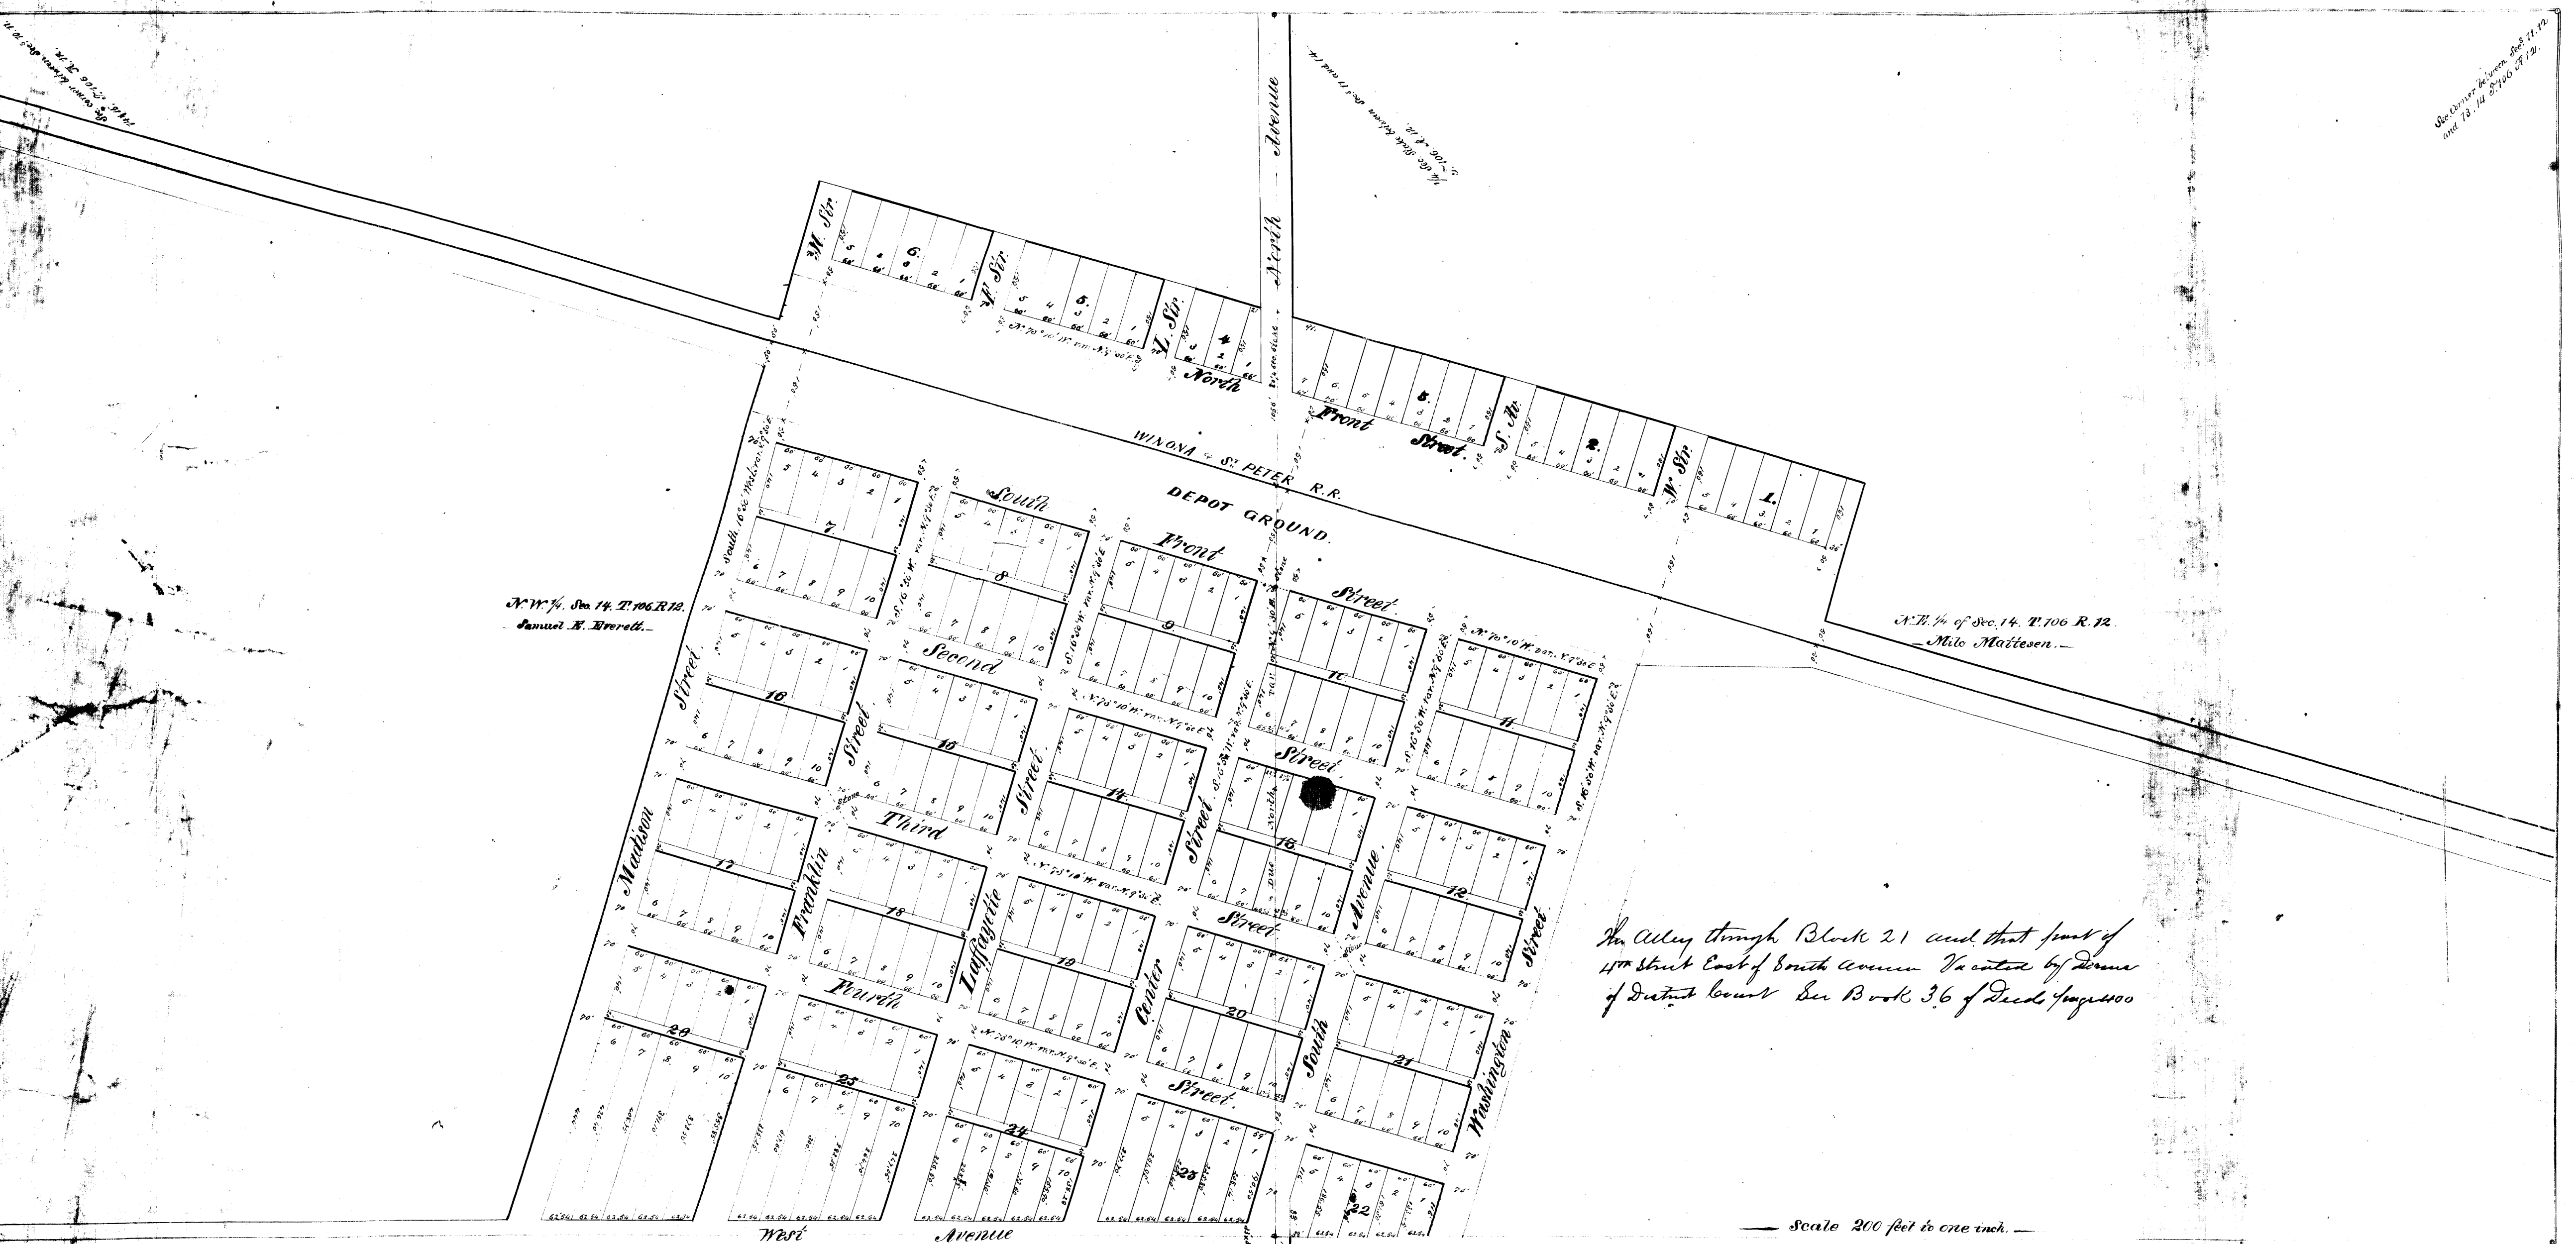

N.W. 1/4, Sec. 14, T. 106, R. 12.  
Samuel E. Everett.

N.E. 1/4 of Sec. 14, T. 106, R. 12.  
Milo Matteson.

The alley through Block 21 and that part of  

Scale 200 feet to one inch.

I hereby certify that the above is a correct plat of the town of Eyota as surveyed by me  
this 25<sup>th</sup> day of October A.D. 1864, and laying in the north east and north west quarters  
of section number fourteen (14) in township number one hundred and six (106) north of range  
number twelve (12) west, Winona county Minnesota.  
The dimensions of the street and alleys and of the blocks, lots and fractional lots are  
as given therein  
Stones from which future surveys are to be made are placed at the intersections of 3<sup>rd</sup> Street and  
South Avenue and 3<sup>rd</sup> and Franklin streets.

J. F. Hilkey,

Filed for Record Dec 27  
1864 at 3 1/2 o'clock P.M.

The undersigned proprietors of Eyota, hereby acknowledging that they procured a survey of the same, of which the above is  
a true plat, for the purpose of record as a town site, and they hereby devote the streets and alleys therein designated to the  
public use and benefit from.  
In testimony whereof they have hereunto set their hands and seals this 25<sup>th</sup> day of October A.D. 1864.  
In presence of  
Benjamin Franklin.  
John Hovel  
Samuel E. Everett  
John Hayes Attorney in fact  
Milo Matteson

State of Minnesota }  
County of Winona }  
I, Samuel C. Everett, }  
County Clerk, do hereby }  
certify that on this 27<sup>th</sup> day of December A.D. 1864, personally appeared before me a notary public  
in and for said county of Winona, Samuel C. Everett by John Hayes Attorney in fact, John Hayes and  
Milo Matteson, and acknowledged the same to their free act and they thereunto expressed.  
Notary Public

Winona & St. Peter R.R.  
T. 106, R. 12, Sec. 14