Index No. 522904

CERTIFICATE OF LOCATION OF GOVERNMENT CORNER

NORTH QUARTER Corner of Section 32 , Township 105N , Range 12W , 5TH P.M.

STATE OF MINNESOTA, County of OLMSTED


At the corner location shown on the sketch:

☒ On 08–31–2021 (DATE) found a 1" SQUARE PIPE AT SURFACE

☒ left monument as found, ☐ lowered monument, ☐ removed monument (explain)

☒ On 6–26–2026 (DATE) placed a 3" MAGSPIKE & DISK AT SURFACE ABOVE 1" PIPE AFTER ROAD CONSTRUCTION

SKETCH OF REFERENCE TIES

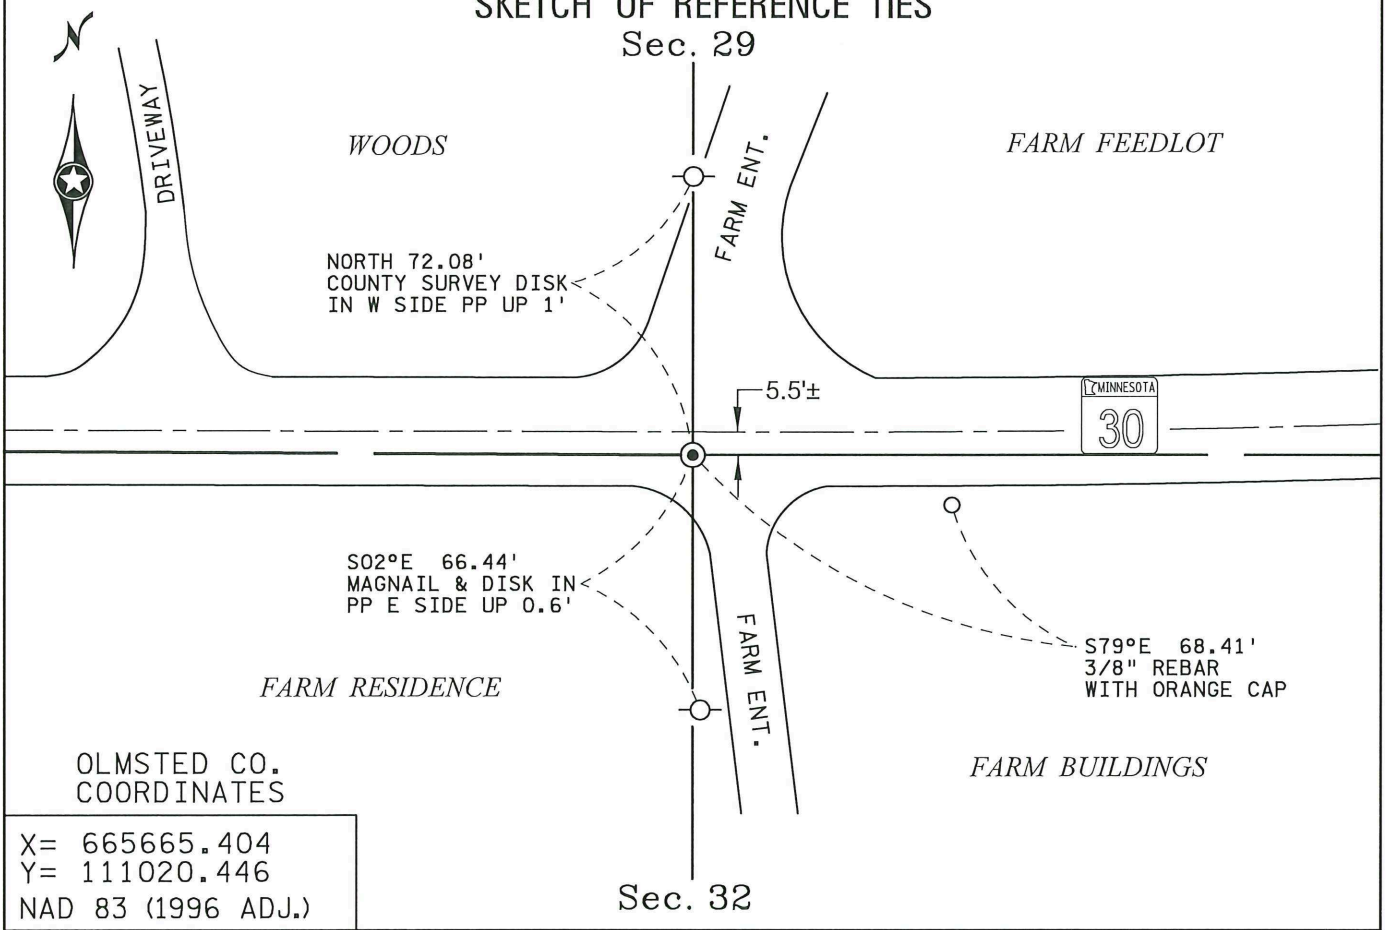

OLMSTED CO. COORDINATES

X= 665665.404
Y= 111020.446
NAD 83 (1996 ADJ.)

Statement of evidence relative to this corner location is on back of page.

I hereby certify that this survey, plan or report was prepared by me or under my direct supervision and that I am a duly Licensed Land Surveyor under the laws of the State of Minnesota.

Dale G Lempke — Signature — 7–21–2026 — Date

Dale G. Lempke — Type or Print Name — 49773 — License No.

OFFICE OF THE COUNTY RECORDER

County of Olmsted

I hereby certify that this document was filed in the Co. Recorder's office at ____ __.M. on the ____ day of _____ A.D., 20 ____

County Recorder _____

By _____, Deputy

DOCUMENT NO. _____

Statement of Evidence:

North Quarter Corner of Section 32, T. 105 N., R. 12 W., 5th P.M. - Olmsted County ID# 522904

10-6-1853	Gov't Notes: West on true line between sections 29 & 32 VAR 10°33'E 39.93 set qr. section post. Aspen 6" N1½ E 353 lks. 79.86 to section corner.
9-1879	T. Hunter Page 363 No. 354 Corner gone & bearing trees gone. Set stake well down M 39.91 chs. 1/16 east drove stake well down M&L 19.95 ½ chs.
Sept 1981	T. Hunter Old Field Book #5. Pg. 125 ¼ post missing. Meas. From 1/16 cor. e. 19.95 ½ e. of ¼ post, set temp. stake & drove iron stake in its place.
4-1901	W. Fraser, P.2B Found iron stake (see bk. 5 pg. 125) M. 39.94 chs. In center road. 1/16 east set stake & stone. 19.96 chs. M&L. 1/16 no. set stake & stone 3" x 6" x 21" M&L 19.95 chs.
6-1981	County Surveyor dug, found nothing
6-17-1981	County Surveyor at 1/16 north went to corner area, projected some fences and commenced a small dig. ,
11-17-1994	County Surveyor set 1" square pipe w/cap in TH 30. At line and double meas. From e. from CIM @ stone loc. At NE 32 to 1/16th iron over stone. The corner falls 5 ½' so. of center line TH 30. Center line farm driveway so. East ±9' CSD in PP #49976 NNE 74.54'.
10-3-2002	County Surveyor found 1" square pipe w/cap down 0.2' in good condition.
8-30-2006	County Surveyor found 1" square pipe with bad cap down 0.4' in good condition. Drilled out old cap and replaced with new cap #15809.
4-25-2007	County Surveyor found 1" square pipe w/cap down 0.3' in good condition. Set reference points and tied out corner.
5-14-2007	County Surveyor removed 1" square pipe w/cap for TH 30 overlay.
8-3-2007	County Surveyor set 1" square pipe w/cap at surface from 2007 overlay tie-out.
11-5-2008	County Surveyor found 1" square pipe w/cap at surface in good condition.
8-31-2021	MnDOT found the 1" square pipe at surface in good condition.
6-26-2026	MnDOT set a 3" magspike and disk at the surface over 1" square pipe after TH 30 mill and overlay in 2025.