Index No. 522905

# CERTIFICATE OF LOCATION OF GOVERNMENT CORNER

NORTHEAST Corner of Section 31, Township 105N, Range 12W, 5TH P.M.

STATE OF MINNESOTA, County of OLMSTED


At the corner location shown on the sketch:

☒ On 08–31–2021 (DATE) found a 1" SQUARE PIPE AT SURFACE

☒ left monument as found, ☐ lowered monument, ☐ removed monument (explain)

☒ On 6–26–2026 (DATE) placed a 3" MAGSPIKE & DISK AT SURFACE ABOVE 1" PIPE AFTER ROAD CONSTRUCTION

## SKETCH OF REFERENCE TIES

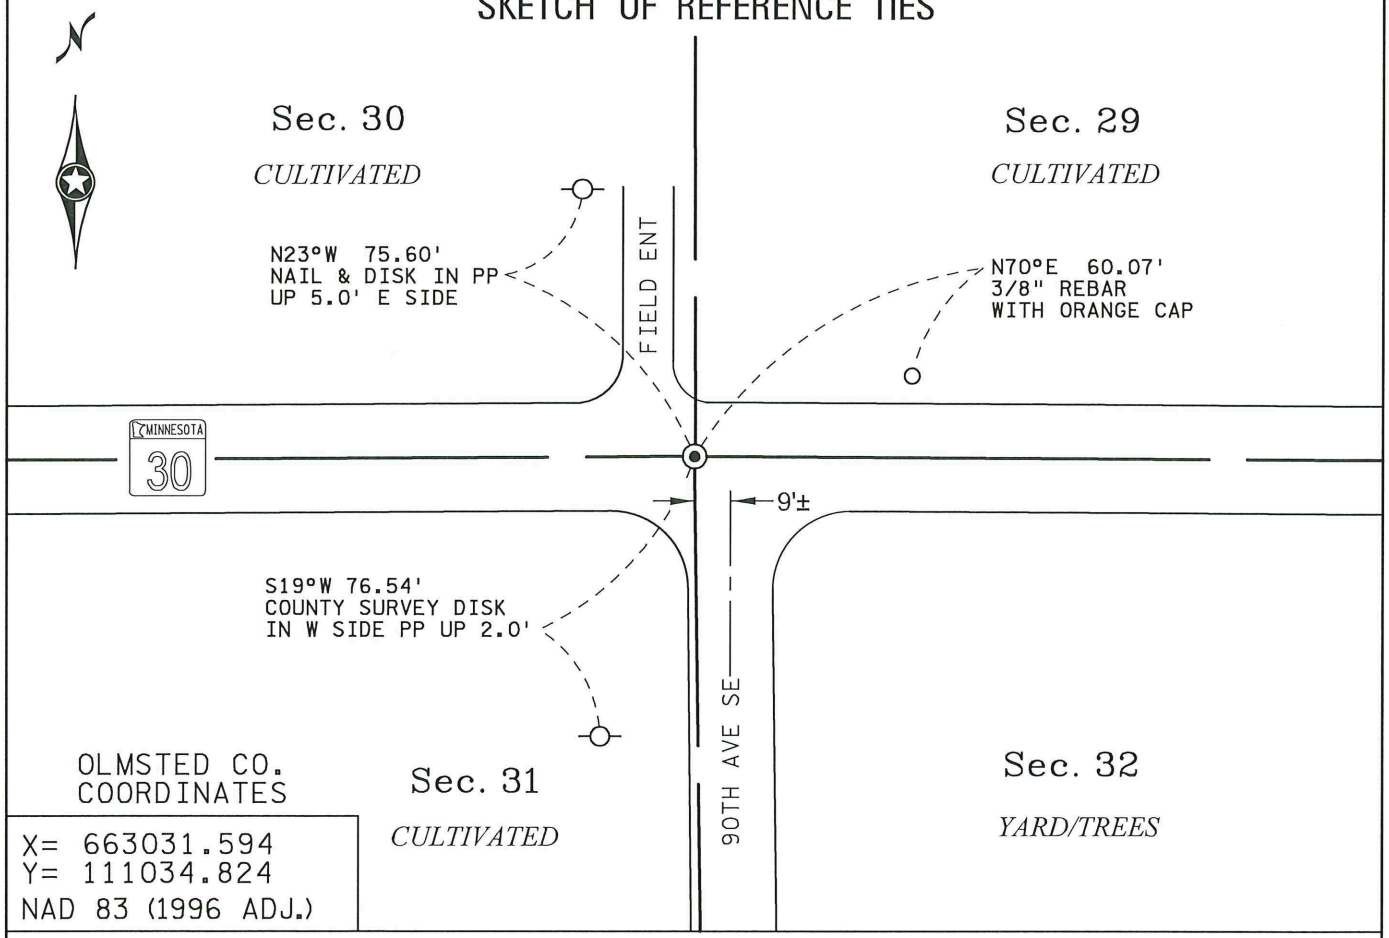


OLMSTED CO. COORDINATES

X= 663031.594
Y= 111034.824
NAD 83 (1996 ADJ.)

Statement of evidence relative to this corner location is on back of page.

I hereby certify that this survey, plan or report was prepared by me or under my direct supervision and that I am a duly Licensed Land Surveyor under the laws of the State of Minnesota.

Dale G. Lempke — Signature — 7–21–2026 — Date

Dale G. Lempke — Type or Print Name — 49773 — License No.

OFFICE OF THE COUNTY RECORDER

County of Olmsted

I hereby certify that this document was filed in the Co. Recorder's office at ____ __.M. on the ____ day of _____ A.D., 20 ____

County Recorder _____

By _____, Deputy

DOCUMENT NO. _____

Statement of Evidence:

**Northeast Corner of Section 31, T. 105 N., R. 12 W., 5th P.M. - Olmsted County ID# 522905**

| | |
|---|---|
| 1854 | Gov't Notes: North between sections 31 & 32 80.00 chs. Set post to sect. 29-30-31-32 W. Oak 14" S49°E 65 lks. R. Oak 13" N53°E 35 lks. R. Oak 11" N57°W 53 lks. W.Oak 11" S88°W 57 lks. |
| 9-1879 | T. Hunter Page 362 No. 353 Found old stake remains from stump. Set stone 2 ½" x 8" x 20" in its place. 1/16 west set stake 19.95 ¾ chs. M&L. Found stone P. 363 set 39.91 chs. M&L |
| 4-1901 | W. Fraser P. 2B Found stone P. 363 and W. Oak bearing tree N18°W 51 lks. 1/16 no. drove iron stake M&L 19.88 chs. 1/64 no. drove stake M&L 9.94 chs. |
| 1940 | County Highway Department Disc tele pole SW 38.4' Disc Oak ESE 76.08'. |
| 6-6-1981 | County Surveyor dug with backhoe and found limestone with '+' cut in top with flat limestone lying over. Set 1" pipe in stake hole. |
| 8-3-1982 | County Surveyor set cast iron cap on telspar pipe from local reference nails of 6-16-1981 over stone found. Corner in center line TH 30 9' W center line crushed rock road south and 3 ½' east of fence north. |
| 10-3-2002 | County Surveyor found cast iron cap on telspar pipe down 0.1' in good condition. |
| 8-30-2006 | County Surveyor found cast iron cap on telspar pipe down 0.1' in good condition. |
| 4-25-2007 | County Surveyor found cast iron cap on telspar pipe down 0.1' in good condition. Set reference pipes and tied out corner. |
| 5-14-2007 | County Surveyor removed cast iron cap on telspar pipe for TH 30 overlay. |
| 8-3-2007 | County Surveyor set 1" square pipe w/cap at surface from 2007 overlay tie out. |
| 11-5 2008 | County Surveyor found 1" square pipe w/cap at surface in good condition. |
| 8-31-2021 | MNDOT found the 1" square pipe in good condition. |
| 6-26-2026 | MNDOT set a 3" magspike and disk at the surface over the 1" square pipe after the TH 30 mill and overlay in 2025. |