Index No. 523005

CERTIFICATE OF LOCATION OF GOVERNMENT CORNER

NORTHEAST Corner of Section 36, Township 105N, Range 13W, 5TH P.M.

STATE OF MINNESOTA, County of OLMSTED


At the corner location shown on the sketch:

☒ On 08–31–2021 (DATE) found a 1" SQUARE PIPE AT SURFACE

☒ left monument as found, ☐ lowered monument, ☐ removed monument (explain)

☒ On 6–26–2026 (DATE) placed a 3" MAGSPIKE & DISK AT SURFACE ABOVE 1" PIPE AFTER ROAD CONSTRUCTION

SKETCH OF REFERENCE TIES

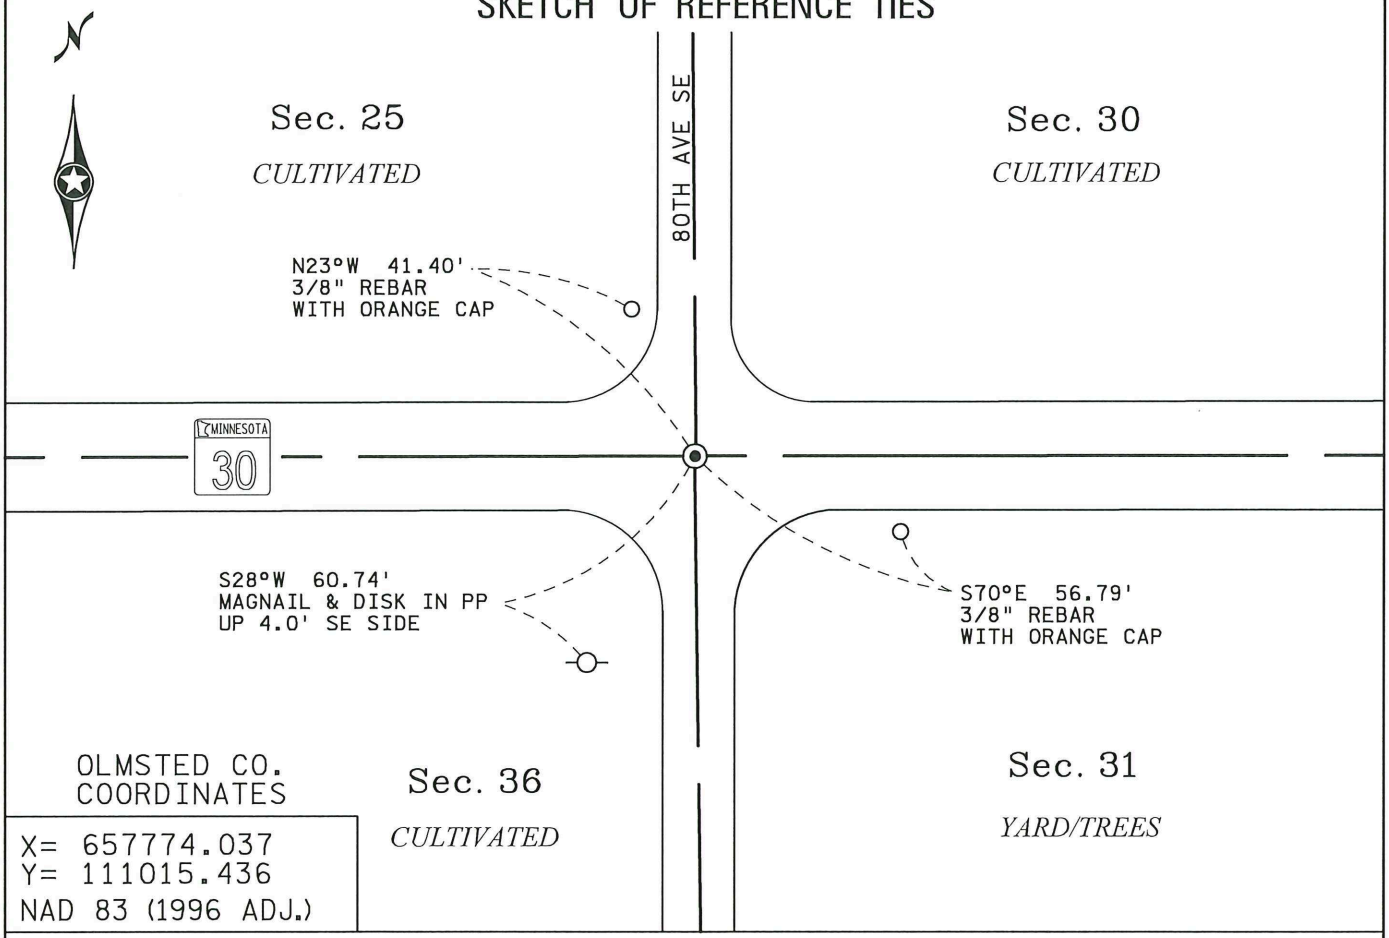

Statement of evidence relative to this corner location is on back of page.

I hereby certify that this survey, plan or report was prepared by me or under my direct supervision and that I am a duly Licensed Land Surveyor under the laws of the State of Minnesota.

Dale G Lempke — Signature — 7–21–2026 — Date

Dale G. Lempke — Type or Print Name — 49773 — License No.

OFFICE OF THE COUNTY RECORDER

County of Olmsted

I hereby certify that this document was filed in the Co. Recorder's office at ____ __.M. on the ____ day of _____ A.D., 20 ____

County Recorder _____

By _____, Deputy

DOCUMENT NO. _____

Statement of Evidence:

Northeast Corner of Section 36, T. 105 N., R. 13 W., 5th P.M. - Olmsted County ID# 523005

1853	Gov't Notes John Ball, Deputy Surveyor: North between sections 31 and 36. 80.00 chs. Set post and drove charred stake for cor. Made trench per instructions, planted SE Osage Orange seeds NE Apple seeds.
7-1857	W.H. Mills, Surveyor, (Old Road Book – Road No.48) surveyed the road between Sections 30 and 31, Orion Twp. And Sections 25 and 36, Pleasant Grove Twp.
9-16-1879	Thomas Hunter, County Surveyor, (Book A, Page 362,No. 353, and Old Field Book 5, Page 104): "This corner is missing, and being in the center of cross roads no remains or other evidence of it could be found on or in the ground, but the owners of the adjacent lands claim that the road fences, the remains of which are still to be found, was set just two rods from the corner and the roads being four rods wide between the fences and the measurement from A (NE 31) to C (NW 31) to the center of the roads, being within two links of the Gov't measurement, we took the center of the cross roads as the place for the section corner, but set no corner or stake, only temporary." Measured 39.93 chs. South to the fenceline east and 39.87 chs. East to ¼ Cor. 30-31. He set a stone at the 1/16 East 20 chs. West of ¼ Cor. 30-31 and on line.
9-1885	Thomas Hunter, County Surveyor (Book A, Page. 401 No. 391, and Old Fieldbook 14, Page 49) states that the temporary stake set here in Survey No.353 was gone. He set a 16" x 9" x 3" stone as the corner on line from ¼ Cor. 30-31 over the stone set in Survey No. 353. He used this corner to set the 1/16 North, a 2" x 7" x 22" stone, midway (19.93 ½ chs.) and on line to the E ¼ Cor. 36, a 3" x 9" x 16" stone, also set midway and on line in this survey. He also set the 1/16 West, a stone midway (19.93 chs.) and on line to the ¼ Cor. 25-36, a stone found in this survey.
1927	County Highway Department (C.H.D. Book 48, Page 11) referenced corner (no description). C.H.D. (Card) 3" x 10" limestone with bridge spike on S. side.
1957	MnDOT R/W map shows "stone in place at sec. cor." This corner is P.I. 506+02.2.
5-5-1973	County Surveyor found the stone at the 1/16 North. Also dug at E. Sec. Cor. 24-25 and found stone.
9-6-1977	County Surveyor dug at E. ¼ Cor. 25 and the 1/16 North of E. ¼ Cor. 25 but did not find anything.
11-25-1980	County Surveyor dug at ¾" P.I. rod at surface of TH 30. Found this iron over another ¾" x 24" iron and several small irons. Found a 3" x 9" x 18"+ limestone 4 ½' deep with base in clay. Set irons around stone. The center of the stone is 0.33' west and 0.13' north of the P.I. rod at the road surface.
12-1-1980	County Surveyor dug at the 1/16 West but found nothing.
12-8-1980	County Surveyor set a 5/8" rod with cap over the stone and at the road surface and set the ¾" P.I. rod back 0.33' east and 0.13' south of the section corner.
10-3-2002	County Surveyor found 5/8" rod w/ alum cap down 0.1' in good condition.
8-30-2006	County Surveyor found 5/8" rod down 0.2' in good condition.
4-25-2007	County Surveyor found 5/8" rerod w/cap own 0.1' in good condition. Set reference pipes and tied out corner.

Statement of Evidence:

Northeast Corner of Section 36, T. 105 N., R. 13 W., 5th P.M. - Olmsted County ID# 523005

5-14-2007	County Surveyor removed 5/8" rerod w/cap for TH 30 overlay.
8-3-2207	County Surveyor set 1" square pipe w/cap at surface from 2007 overlay tie out.
11-5-2008	County Surveyor found 1" square pipe w/cap at surface good condition.
8-31-2021	MNDOT found 1" square pipe good condition.
6-26-2026	MNDOT set a 3" magspike and disk at the surface over the 1" square pipe after the TH 30 mill and overlay in 2025.