Index No. 533106

CERTIFICATE OF LOCATION OF GOVERNMENT CORNER

EAST QUARTER Corner of Section 36 , Township 105N , Range 14W , 5TH P.M.

STATE OF MINNESOTA, County of OLMSTED


At the corner location shown on the sketch:

☒ On 08–31–2021 (DATE) found a 1" SQUARE PIPE

☒ left monument as found, ☐ lowered monument, ☐ removed monument (explain)

☒ On 6–26–2026 (DATE) placed a 3" MAGSPIKE & DISK AT SURFACE ABOVE 1" PIPE AFTER ROAD CONSTRUCTION

SKETCH OF REFERENCE TIES

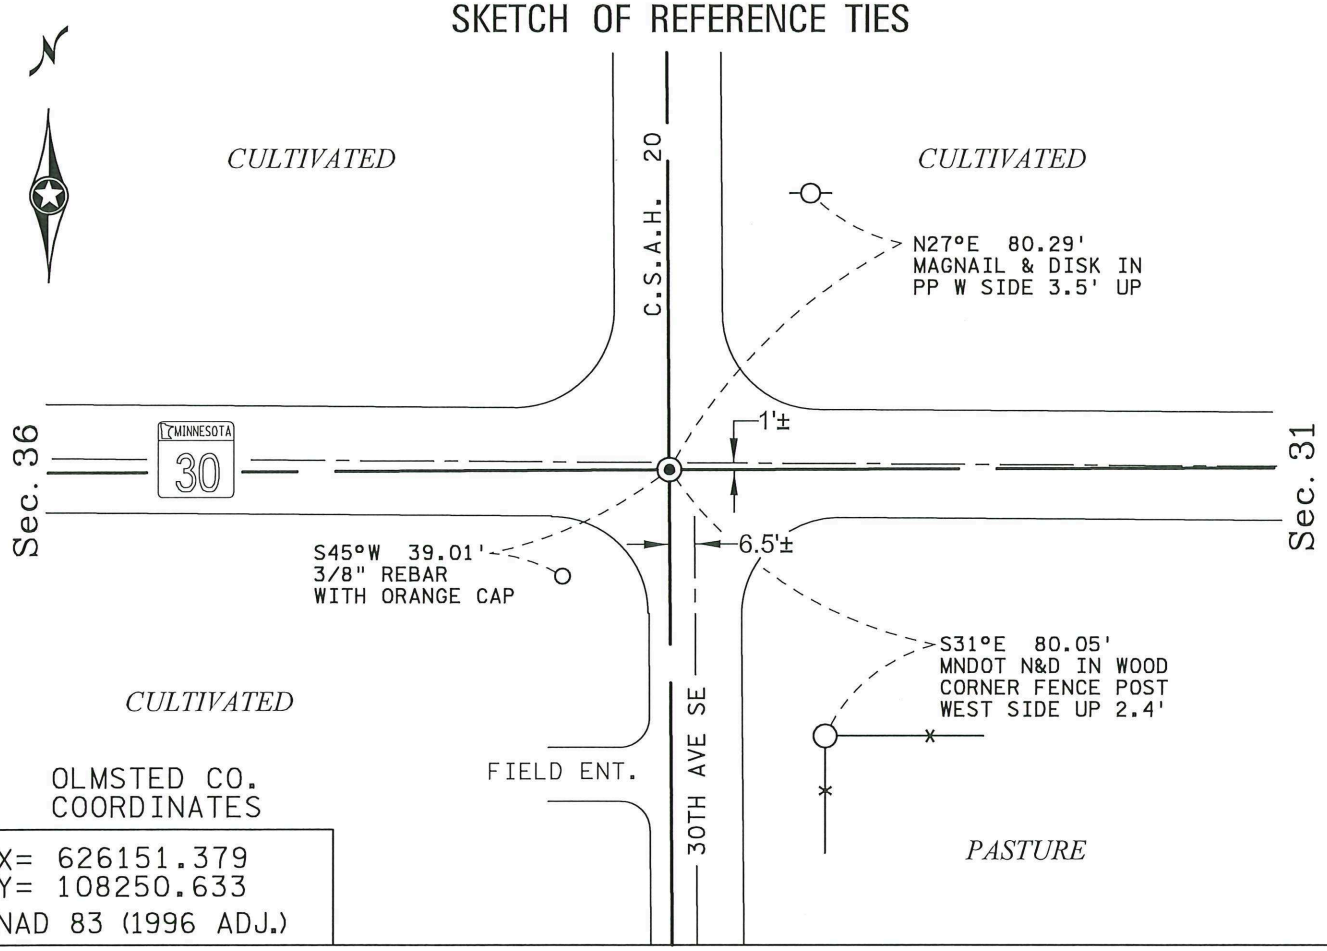

OLMSTED CO. COORDINATES

X= 626151.379
Y= 108250.633
NAD 83 (1996 ADJ.)

Statement of evidence relative to this corner location is on back of page.

I hereby certify that this survey, plan or report was prepared by me or under my direct supervision and that I am a duly Licensed Land Surveyor under the laws of the State of Minnesota.

Dale G Lempke — Signature — 7–21–2026 — Date

Dale G. Lempke — Type or Print Name — 49773 — License No.

OFFICE OF THE COUNTY RECORDER

County of Olmsted

I hereby certify that this document was filed in the Co. Recorder's office at ____ __.M. on the ____ day of _____ A.D., 20 ____

County Recorder _____

By _____, Deputy

DOCUMENT NO. _____

Statement of Evidence:

East Quarter Corner of Section 36, T. 105 N., R. 14 W., 5th P.M. - Olmsted County ID# 533106

1853	Gov't Notes 40.00 set post and drove charred stake for quarter section corner. Built mound with trench and planted SE osage orange seeds and NE apple seeds.
7-1965	J. Kerr (Bk. 90 Pg. 23) found iron rod center blacktop Minn. Hwy 30 set by state on running line over this point 2 ½ miles North, hit exact point of W ¼ 19 a long time corner accepted chainage of 2638.4 from SW 31. Although next 2 miles 2631.31 each left rod as is center cross section roads. ¾" iron 1.55 South of center line State Highway 30.
6-11-2002	County Surveyor found ¾" rod in good condition.
10-3-2002	County Surveyor found 5/8" re-rod down 0.4' in good condition.
8-20-2003	County Surveyor found ¾" iron down 0.4'. Took local ties and removed. Set 1" square pipe w/cap at surface.
8-30-2006	County Surveyor found 1" square pipe w/cap at surface in good condition.
4-23-2007	County Surveyor found 1" square pipe w/cap at surface in good condition. Set reference pipes and tied out corner.
5-14-2007	County Surveyor removed 1" square pipe w/cap for TH 30 overlay.
8-2-2007	County Surveyor set pk nail at surface from 2007 overlay tie out.
8-6-2007	County Surveyor set 1" square pipe with RLS Cap #15809 over pk nail.
8-31-2021	MnDOT found square pipe in good condition.
6-26-2026	MnDOT set a 3" magspike and disk at the surface over the 1" square pipe after the TH 30 mill and overlay.