Index No. 533306

# CERTIFICATE OF LOCATION OF GOVERNMENT CORNER

EAST QUARTER Corner of Section 32 , Township 105N , Range 13W , 5TH P.M.

STATE OF MINNESOTA, County of OLMSTED


At the corner location shown on the sketch:

☒ On 08–31–2021 (DATE) found a 1" SQUARE PIPE AT SURFACE

☒ left monument as found, ☐ lowered monument, ☐ removed monument (explain)

☒ On 6–26–2026 (DATE) placed a 3" MAGSPIKE & DISK AT SURFACE ABOVE 1" PIPE AFTER ROAD CONSTRUCTION

## SKETCH OF REFERENCE TIES

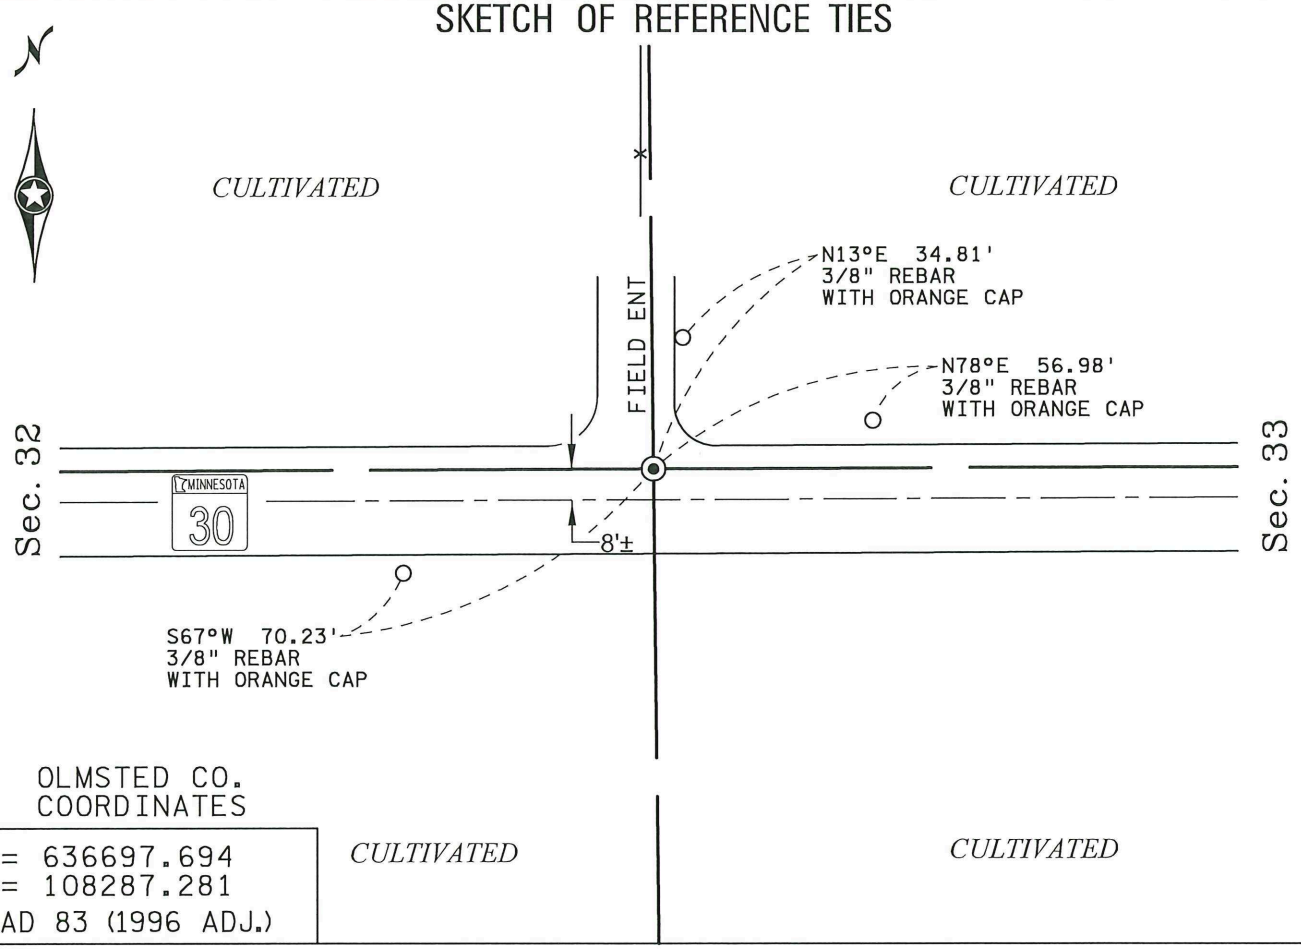


OLMSTED CO. COORDINATES

X= 636697.694
Y= 108287.281
NAD 83 (1996 ADJ.)

Statement of evidence relative to this corner location is on back of page.

I hereby certify that this survey, plan or report was prepared by me or under my direct supervision and that I am a duly Licensed Land Surveyor under the laws of the State of Minnesota.

Dale G Lempke — Signature — 7–21–2026 — Date

Dale G. Lempke — Type or Print Name — 49773 — License No.

OFFICE OF THE COUNTY RECORDER

County of Olmsted

I hereby certify that this document was filed in the Co. Recorder's office at ____ __.M. on the ____ day of _____ A.D., 20 ____

County Recorder _____

By _____, Deputy

DOCUMENT NO. _____

Statement of Evidence:

**East Quarter Corner of Section 32, T. 105 N., R. 13 W., 5th P.M. - Olmsted County ID# 533306**

| | |
|---|---|
| 5-1854 | Gov't Notes Michael Karrick, Deputy Surveyor: North between Sections 32 and 33. 40.00 chs. Set quarter section post in mound with trench, pits, and charred stake with Osage Orange seeds N.E. and S.W. |
| 9-1893 | William C. Fraser, Deputy County Surveyor, (Book A, Page 528, No. 493) "Could find nothing so located 1/2S post on line and midway (39.94-1/2 chs.) between H (Sec. Cor. 28-29-32-33) and E (S Sec. Cor. 32-33). Planted stone 21" x 8" x 4." |
| 8-1902 | O.H. Case, Fillmore County Surveyor, (Book B, Page 45) used this corner (no description) to set the Center 33. |
| 1930 | County Highway Department (C.H.D. Book 57, Page 44) found stone. RPs – 40" willow N 51.23, 12" willow NW 62.23, spike in fence post N 37.8, hub SE 47.4, hub SW 47.9. (All gone likely) |
| 5-1942 | John Kerr, County Surveyor, (Kerr Book 27. Page 4) "Set plow lay for ¼ cor." midway (2633.9) and on line between the section corners. |
| 1950's | MnDOT TH 30 R/W Map shows a plow share in place as ¼ corner 7.4 North of P.O.T. Sta. 237+55.8. |
| 12-4-1980 | County Surveyor dug and found Will Fraser's recorded stone. Also found Kerr's plow share 1.0 East and 0.25 North of the stone. Set the plow share on the North side of the stone and a ¾" iron on the South side. Set a ½" rod at the road surface over the stone. RPs – punched cross in lug at top end C.M.P. in field drive NE 44.70, CSD in SW side PP# 15031 NW 99.60, CSD east side corner post NNW 64.66. |
| 8-23-1982 | County Surveyor drove a square pipe (telspar) with Cast Iron Cap down over the ½" rod set 12-4-1980 over the stone found. The corner is 7.36 North and 0.73 West of the MnDOT P.O.T. and 8' North of centerline T.H. 30, CSD in SW side PP#15031 NW 99.54, CSD in east side corner post NNW 64.65. |
| 10-3-2002 | County Surveyor found telspar pipe without C.I. cap at surface in good condition. Replaced cast iron cap down 0.2'. |
| 8-30-2006 | County Surveyor found cast iron cap on telspar pipe at down 0.1' in good condition. |
| 4-23-2007 | County Surveyor found cast iron cap on telspar pipe at down 0.2' in good condition. Set reference pipes and tied out corner. |
| 5-14-2007 | County Surveyor removed cast iron cap on telspar pipe for TH 30 overlay. |
| 8-2-2007 | County Surveyor set pk nail at surface from 2007 overlay tie-out. |
| 8-6-2007 | County Surveyor set 1" square pipe w/cap at surface over pk nail. |
| 8-31-2021 | MNDOT found 1" square pipe good condition. |
| 6-26-2026 | MNDOT set a 3" magspike and disk at the surface over the 1" square pipe after the TH 30 mill and overlay in 2025. |