Index No. 543506

CERTIFICATE OF LOCATION OF GOVERNMENT CORNER

EAST QUARTER Corner of Section 34 , Township 105N , Range 14W , 5TH P.M.

STATE OF MINNESOTA, County of OLMSTED


At the corner location shown on the sketch:

☒ On 08–31–2021 (DATE) found a 1" SQUARE PIPE

☒ left monument as found, ☐ lowered monument, ☐ removed monument (explain)

☒ On 6–26–2026 (DATE) placed a 3" MAGSPIKE & DISK AT SURFACE ABOVE CAST IRON MONUMENT AFTER ROAD CONSTRUCTION

SKETCH OF REFERENCE TIES

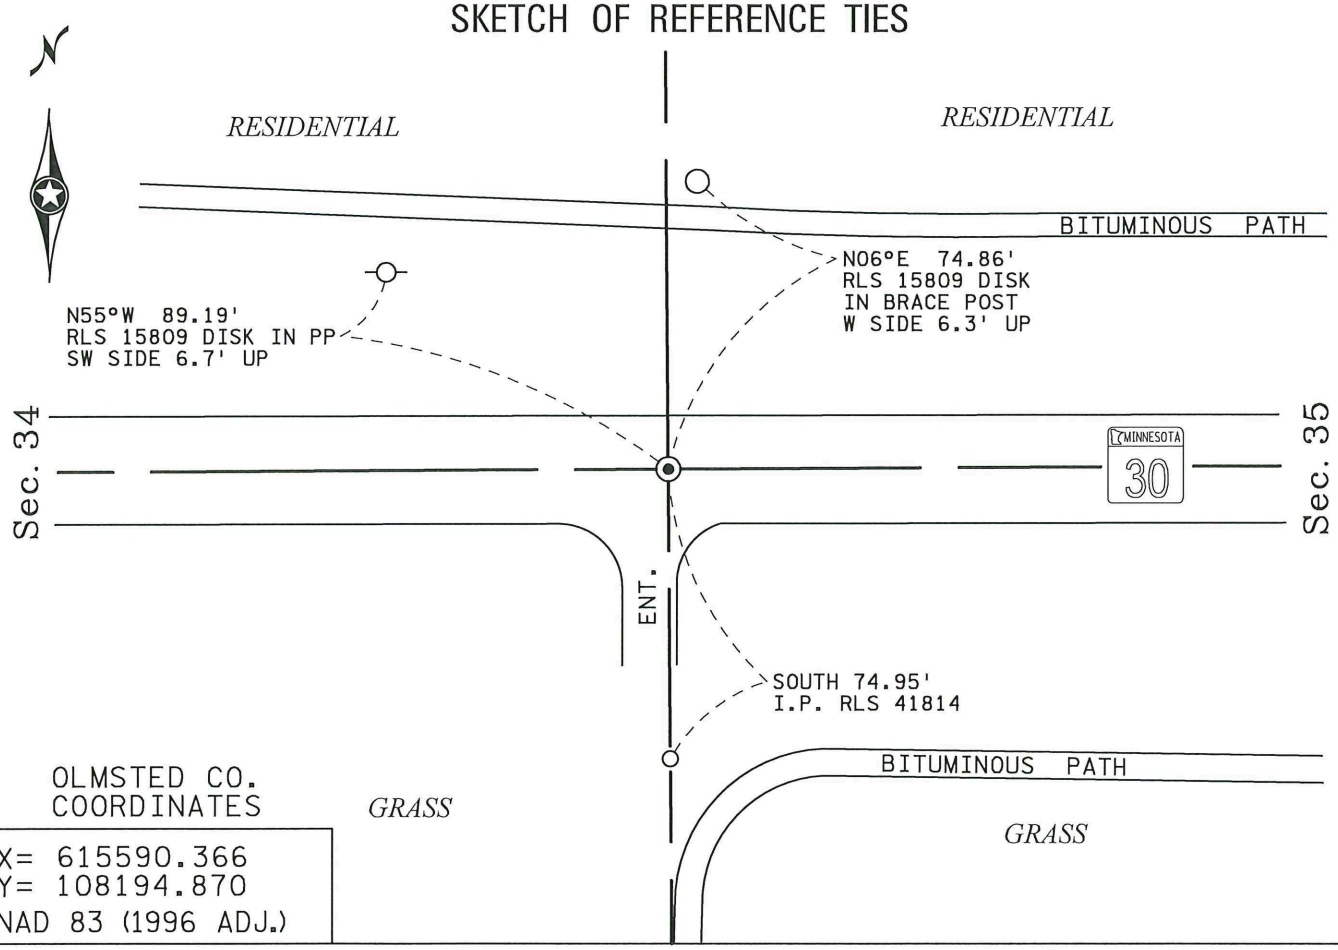

OLMSTED CO. COORDINATES

X= 615590.366
Y= 108194.870
NAD 83 (1996 ADJ.)

Statement of evidence relative to this corner location is on back of page.

I hereby certify that this survey, plan or report was prepared by me or under my direct supervision and that I am a duly Licensed Land Surveyor under the laws of the State of Minnesota.

Dale G Lempke
Signature

7–21–2026
Date

Dale G. Lempke
Type or Print Name

49773
License No.

OFFICE OF THE COUNTY RECORDER

County of Olmsted

I hereby certify that this document was filed in the Co. Recorder's office at ____ __.M. on the ____ day of _____ A.D., 20 ____

County Recorder _____

By _____, Deputy

DOCUMENT NO. _____

Statement of Evidence:

East Quarter Corner of Section 34, T. 105 N., R. 14 W., 5th P.M. - Olmsted County ID# 543506

1853	Gov't Notes: 40.00 chs. Set ¼ section post. Burr Oak 12 in. S19°E 528 lks. Burr Oak 13 in. S76°W 592 lks.
6-1892	T. Fraser P.488 No. 413. All evidence of corner gone-reset large boulder with cross with stake under edge on North-South Section line intersected by East-West Quarter line, West Quarter over center.
4-1909	C. Armstrong P.316B could not find boulder. Ran line from center 34 over 1/16 stone found, doubled 1323 and set limestone 6 x 10 x 30 with cross. This fell in line north-south fence and 27' south of corner fence.
7-1930	County Highway Department P.39 Bk.57 found old oak stake 18" deep in good condition.
4-30-1970	County Surveyor dug for stone but found nothing. Set ¾" rod at ¼ corner.
3-5-1992	Yaggy Colby Associates found a ¾" rod set by Roger Brand 4-30-70, in the center line of TH 30 and in line with fence south (rod is 0.3' below bituminous surface).
6-12-2002	County Surveyor found ¾" rod in good condition.
8-30-2006	County Surveyor found ¾" rod down 0.3' in good condition. Took local ties and removed. Will replace after filled with blacktop.
9-11-2006	County Surveyor set 1" square pipe w/ cap at surface from local ties.
4-23-2007	County Surveyor found 1" square pipe w/ cap at surface in good condition. Set reference pipes and tied out corner.
5-14-2007	County Surveyor removed 1" square pipe w/ cap for TH 30 overlay.
8-2-2007	County Surveyor set pk nail at surface from 2007 overlay tie out.
8-6-2007	County Surveyor set 1" square pipe with RLS #15809 cap at surface over pk nail.
8-31-2021	MnDOT found 1" square pipe at surface in good condition.
6-26-2026	MNDOT set a 3" magspike and disk at the surface over the 1" square pipe after the TH 30 mill and overlay in 2025.