Index No. 543606

CERTIFICATE OF LOCATION OF GOVERNMENT CORNER

EAST QUARTER Corner of Section 35 , Township 105N , Range 14W , 5TH P.M.

STATE OF MINNESOTA, County of OLMSTED


At the corner location shown on the sketch:

☒ On 08–31–2021 found a CAST IRON MONUMENT
DATE

☒ left monument as found, ☐ lowered monument, ☐ removed monument (explain)

☐ On _____ placed a _____
DATE

SKETCH OF REFERENCE TIES

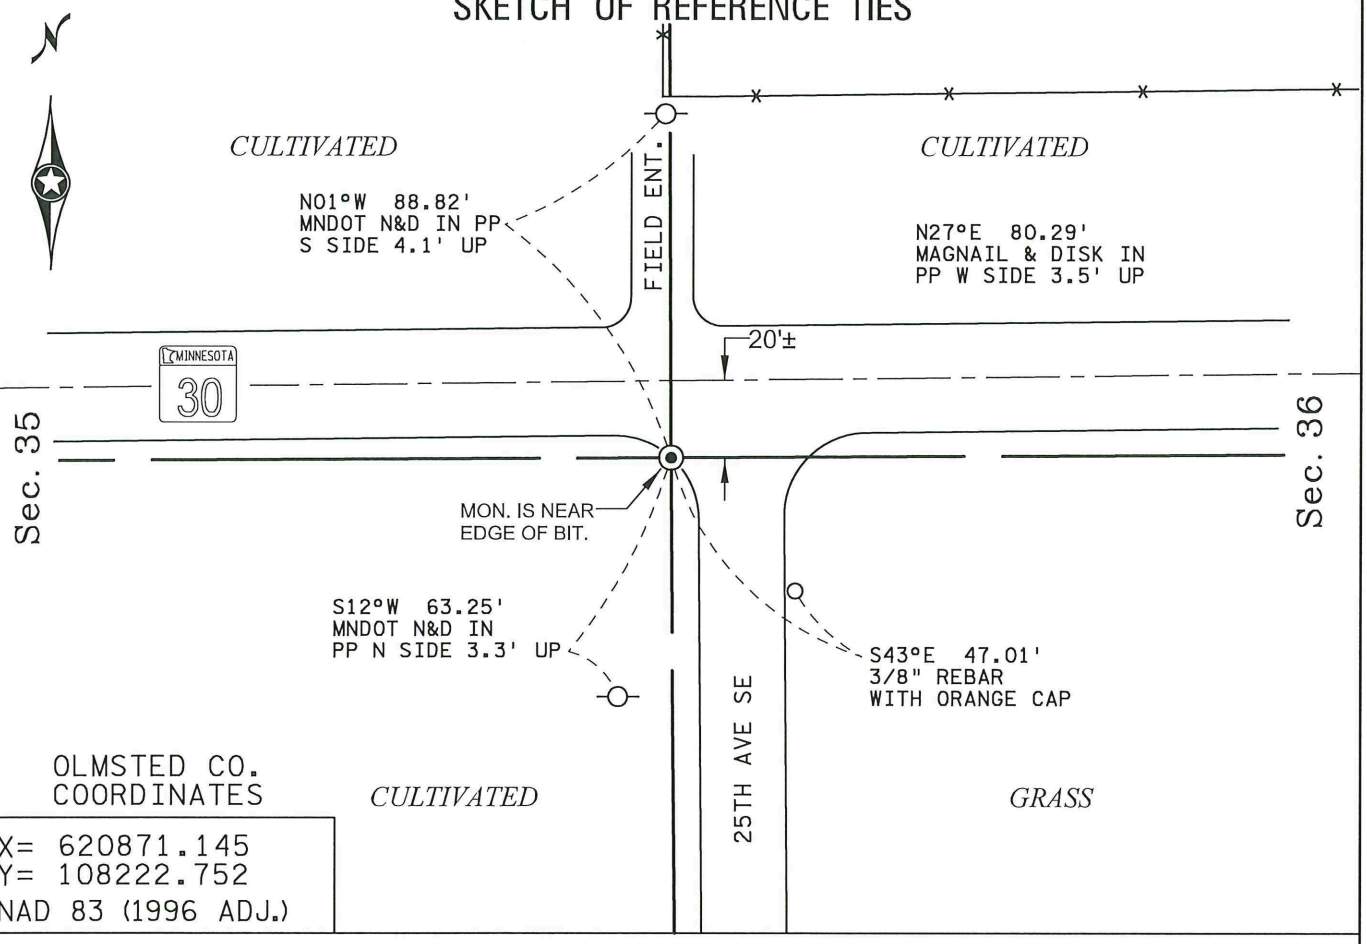

OLMSTED CO. COORDINATES

X= 620871.145
Y= 108222.752
NAD 83 (1996 ADJ.)

Statement of evidence relative to this corner location is on back of page.

I hereby certify that this survey, plan or report was prepared by me or under my direct supervision and that I am a duly Licensed Land Surveyor under the laws of the State of Minnesota.

Dale G Lempke
Signature

7–21–2026
Date

Dale G. Lempke
Type or Print Name

49773
License No.

OFFICE OF THE COUNTY RECORDER

County of Olmsted

I hereby certify that this document was filed in the Co. Recorder's office at ____ __.M. on the ____ day of _____ A.D., 20 ____

County Recorder _____

By _____, Deputy

DOCUMENT NO. _____

Statement of Evidence:

East Quarter Corner of Section 35, T. 105 N., R. 14 W., 5th P.M. - Olmsted County ID# 543606

1853	Gov't Notes, Yerby: 40.0 set post of ¼ section in mound of earth sod, deposited charcoal, made trench, pits, and planted osage orange seeds E & W.
	There are no early records on this corner. The MHD used the line of fences running North and the center of the East-West roads in place in 1930. Also, about this same time the county highway department used the temporary corner. The corner was reset midway and online with the Sec. corner 35-36 and a large concrete anchored steel corner post accepted as the corner of 25,26,35,36.
7-1930	County Highway Department Bk.57 Pg.42; couldn't find stone. Farmer avers corner stone once in place.
11-12-1971	County Surveyor set CIM at 2641.81 M&L. RPs – 20'N to centerline Hwy 30. 20' E to centerline road S, 50.81 SE to chisel cut center top E end galv. culvert, 28.37 SSW to single punch mark in lug clamp W end culvert.
1-19-2001	County Surveyor found CIM down 0.4' in good condition.
8-30-2006	County Surveyor found CIM down 0.6' in good condition.
4-23-2007	County Surveyor found CIM down 0.5' in good condition. Set reference pipe and tied out corner.
8-2-2007	County Surveyor found CIM down 0.7' in good condition.
8-31-2021	MnDOT found CIM in good condition.
6-26-2026	After the TH 30 mill and overlay, the CIM is near the edge of the bituminous pavement on the right turn lane south onto the township road and is still accessible. MnDOT updated the reference ties.