Index No. 550604

CERTIFICATE OF LOCATION OF GOVERNMENT CORNER

South Quarter Corner of Section 06 Township 105 N Range 15 W 5th P.M.


STATE OF MINNESOTA, County of Olmsted
At the corner location shown on the sketch:

☒ On September 11, 2026 found a Cast Iron Cap on Telspar Pipe down 0.6 feet. Updated ties and took photos.

☒ left monument as found, ☐ lowered monument, ☐ removed monument (explain)

☐ On _____ set a _____

Sketch of Reference Ties

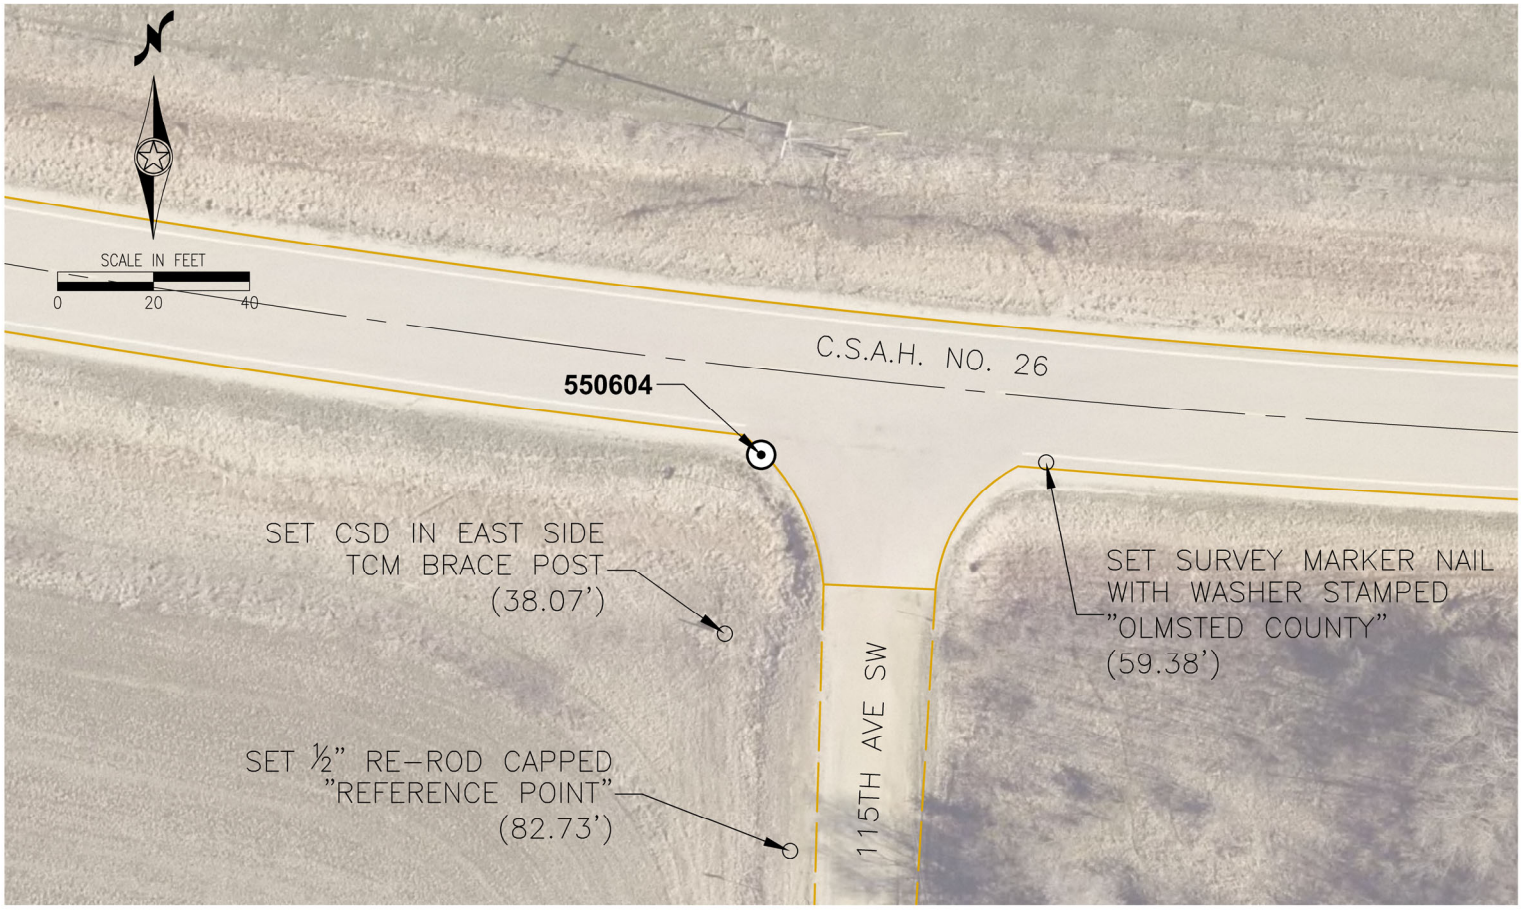

For Statement of Evidence Information, Please Contact the Olmsted County Surveyor's Office.

License No. 57072

☒ County Surveyor

☐ Deputy County Surveyor

☐ Land Surveyor

I hereby certify that this plan, survey or report was prepared by me or under my direct supervision and is correct and complete to the best of my knowledge and belief and that I am a duly Licensed Land Surveyor under the laws of the State of Minnesota.

Eric C. Stenman
Signature

September 29, 2026
Date