Index No. 552805

CERTIFICATE OF LOCATION OF GOVERNMENT CORNER

Southwest Corner of Section 28 Township 105 N Range 15 W 5th P.M.


STATE OF MINNESOTA, County of Olmsted
At the corner location shown on the sketch:

☒ On October 08, 2026 found No monument at corner due to construction.

☐ left monument as found, ☐ lowered monument, ☐ removed monument (explain)

☒ On October 08, 2026 set a 1" Square Pipe with Aluminum Cap at surface. Corner falls 1.0 feet west of centerline of C.S.A.H. NO. 3, in line with fence west and 13.0 feet south of field drive east.

Sketch of Reference Ties

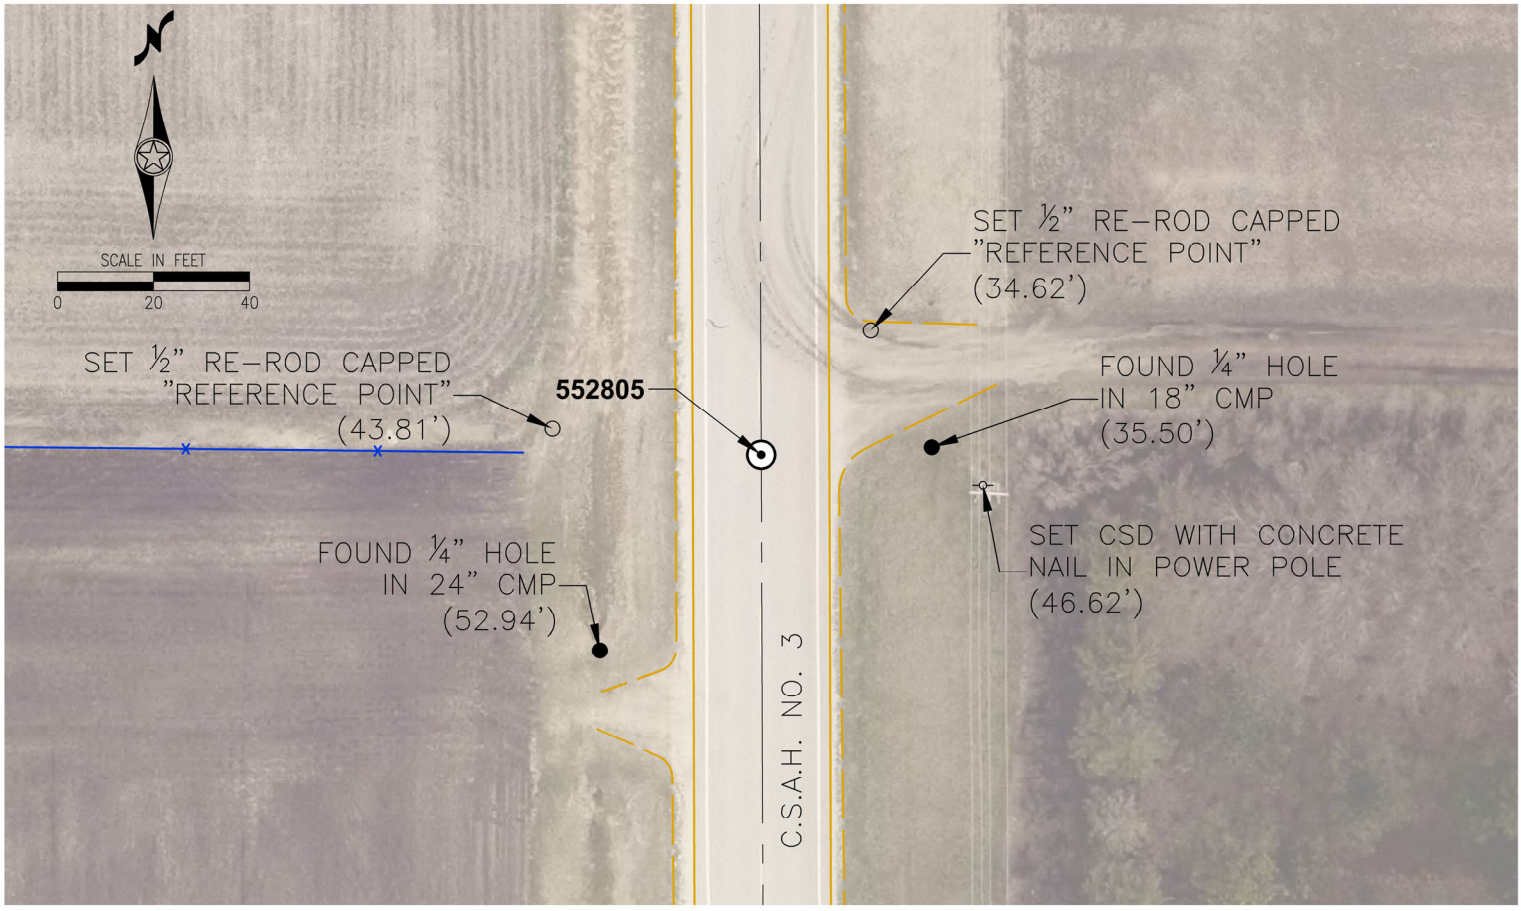

For Statement of Evidence Information, Please Contact the Olmsted County Surveyor's Office.

License No. 57072

☒ County Surveyor

☐ Deputy County Surveyor

☐ Land Surveyor

I hereby certify that this plan, survey or report was prepared by me or under my direct supervision and is correct and complete to the best of my knowledge and belief and that I am a duly Licensed Land Surveyor under the laws of the State of Minnesota.

Eric C. Stenman
Signature

October 15, 2026
Date