Index No. 612005

CERTIFICATE OF LOCATION OF GOVERNMENT CORNER

Southwest Corner of Section 20 Township 106 N Range 11 W 5th P.M.


STATE OF MINNESOTA, County of Olmsted
At the corner location shown on the sketch:

☒ On September 19, 2025 found a No monument at corner due to construction.

☐ left monument as found, ☐ lowered monument, ☐ removed monument (explain)

☒ On October 01, 2025 set a 1" Square Pipe with Aluminium Cap at surface. Corner falls 7.0 feet east of centerline of C.S.A.H. NO. 32 and 4.0 feet south of centerline of township road west.

Sketch of Reference Ties

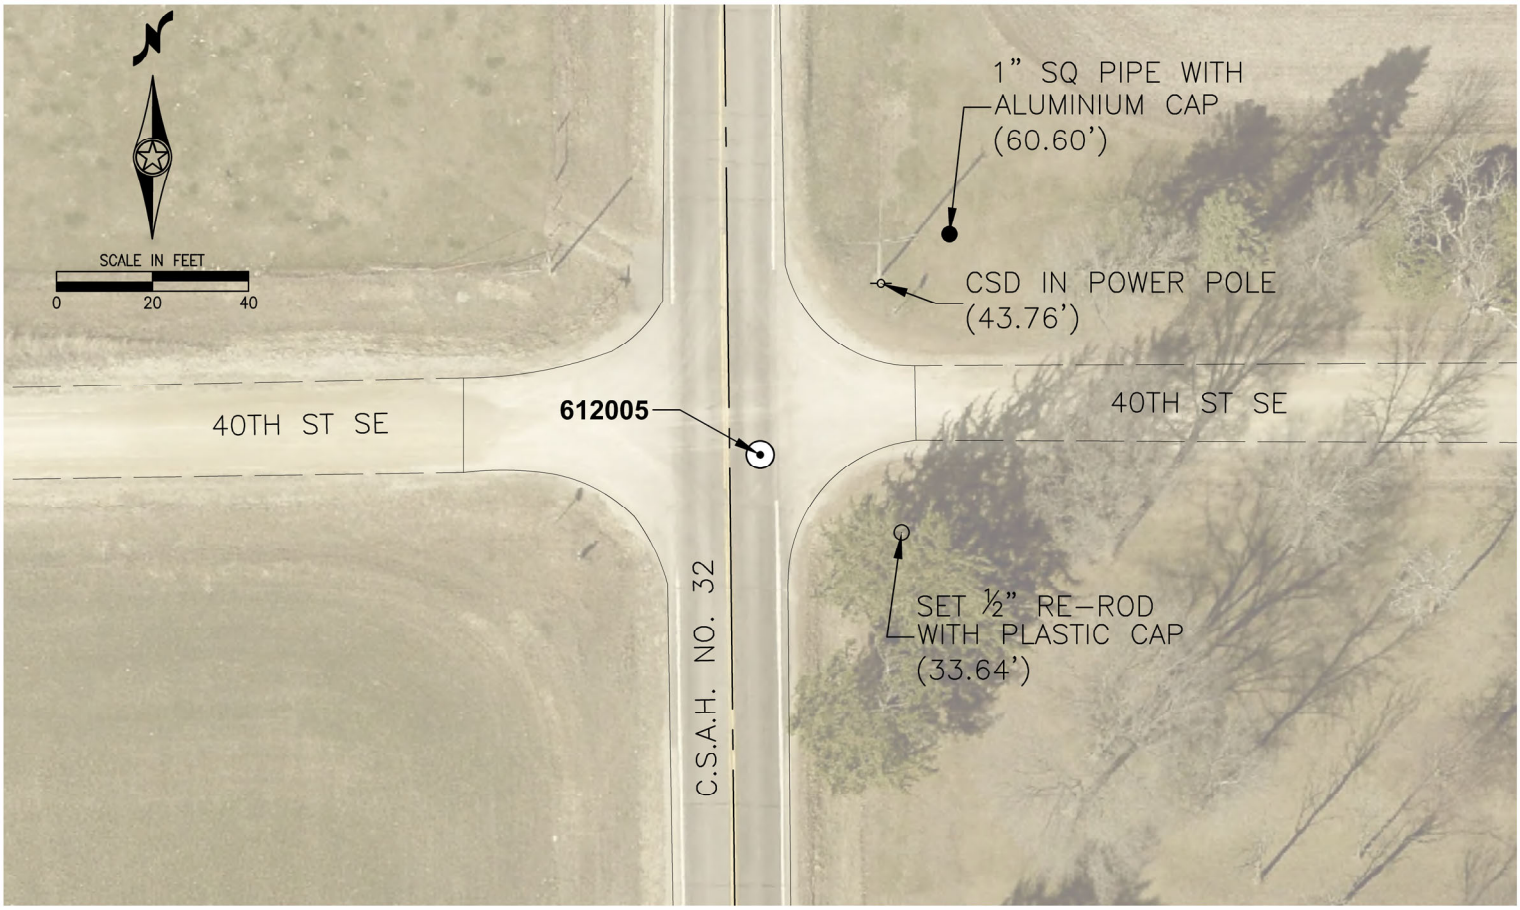

For Statement of Evidence Information, Please Contact the Olmsted County Surveyor's Office.

License No. 57072

☒ County Surveyor

☐ Deputy County Surveyor

☐ Land Surveyor

I hereby certify that this plan, survey or report was prepared by me or under my direct supervision and is correct and complete to the best of my knowledge and belief and that I am a duly Licensed Land Surveyor under the laws of the State of Minnesota.

Eric C. Stemmer
Signature

October 07, 2025
Date