Index No. 612905

CERTIFICATE OF LOCATION OF GOVERNMENT CORNER

Southwest Corner of Section 29 Township 106 N Range 11 W 5th P.M.


STATE OF MINNESOTA, County of Olmsted
At the corner location shown on the sketch:

☒ On September 19, 2025 found No monument at corner due to construction.

☐ left monument as found, ☐ lowered monument, ☐ removed monument (explain)

☐ On October 02, 2025 set a 1" Square Pipe with Aluminum Cap at surface. Corner falls in centerline of C.S.A.H. NO. 32 and in centerline of CR. NO. 129.

Sketch of Reference Ties

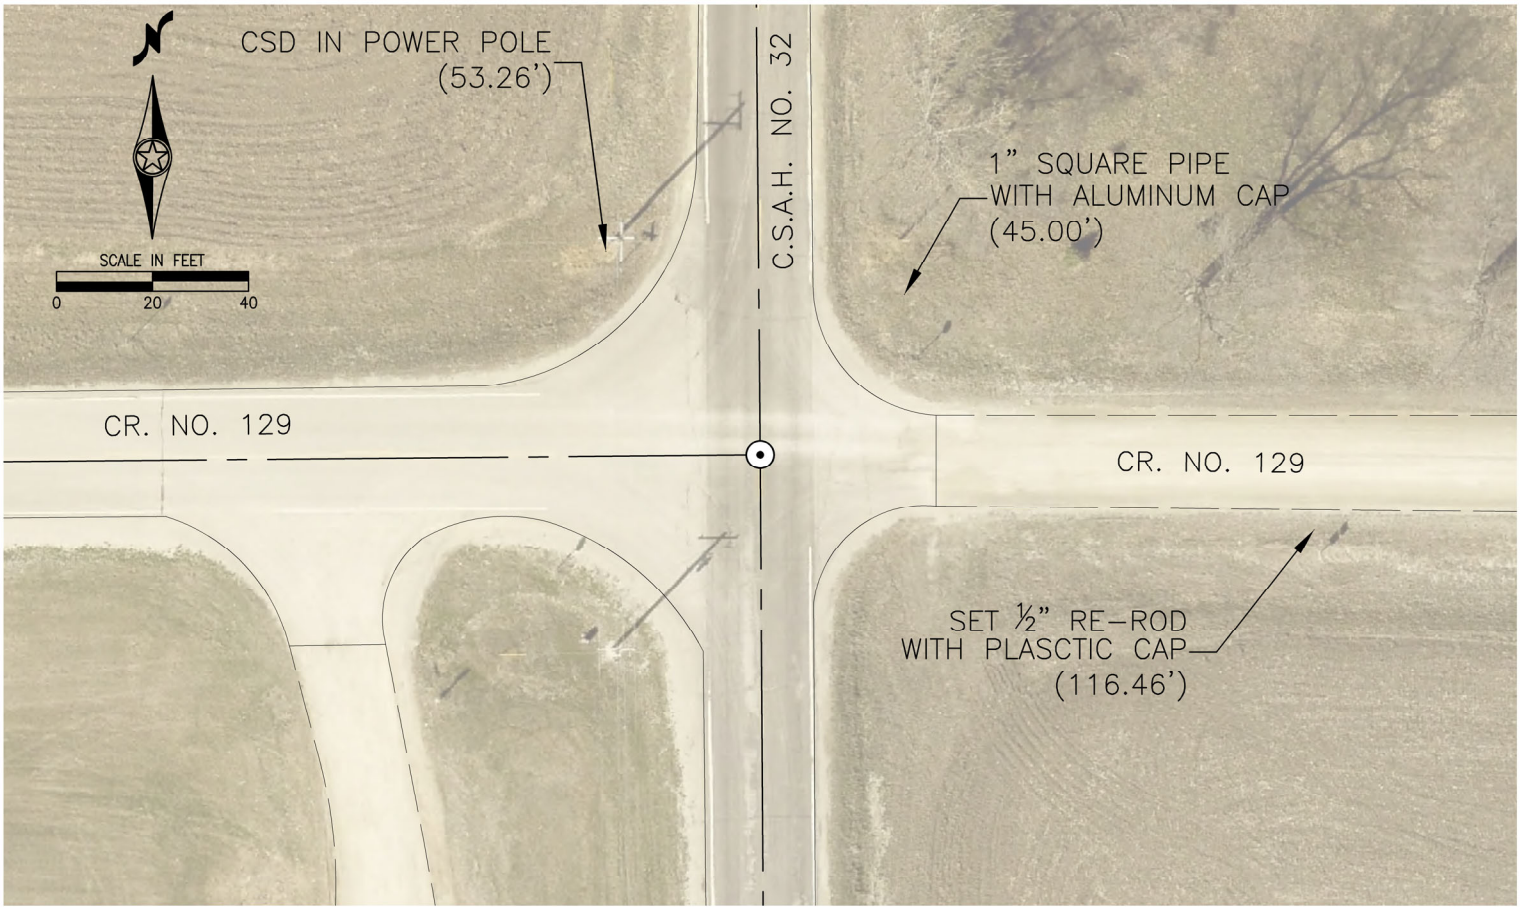

For Statement of Evidence Information, Please Contact the Olmsted County Surveyor's Office.

License No. 57072

☒ County Surveyor

☐ Deputy County Surveyor

☐ Land Surveyor

I hereby certify that this plan, survey or report was prepared by me or under my direct supervision and is correct and complete to the best of my knowledge and belief and that I am a duly Licensed Land Surveyor under the laws of the State of Minnesota.

Eric C. Stemmer
Signature

October 08, 2025
Date