Index No. 640105

CERTIFICATE OF LOCATION OF GOVERNMENT CORNER

Southwest Corner of Section 01 Township 106 N Range 14 W 5th P.M.


STATE OF MINNESOTA, County of Olmsted
At the corner location shown on the sketch:

☒ On July 15, 2025 found a 1" Square Pipe with Aluminum Cap (at surface), damaged. Removed monument for construction.

☐ left monument as found, ☐ lowered monument, ☒ removed monument (explain)

☒ On August 13, 2025 set a 1" Square Pipe with Aluminum Cap (at surface). Corner falls 2 feet north of centerline of west-bound lane of Trunk Highway 14 (12th St SE) and in centerline of 3rd Ave SE.

Sketch of Reference Ties

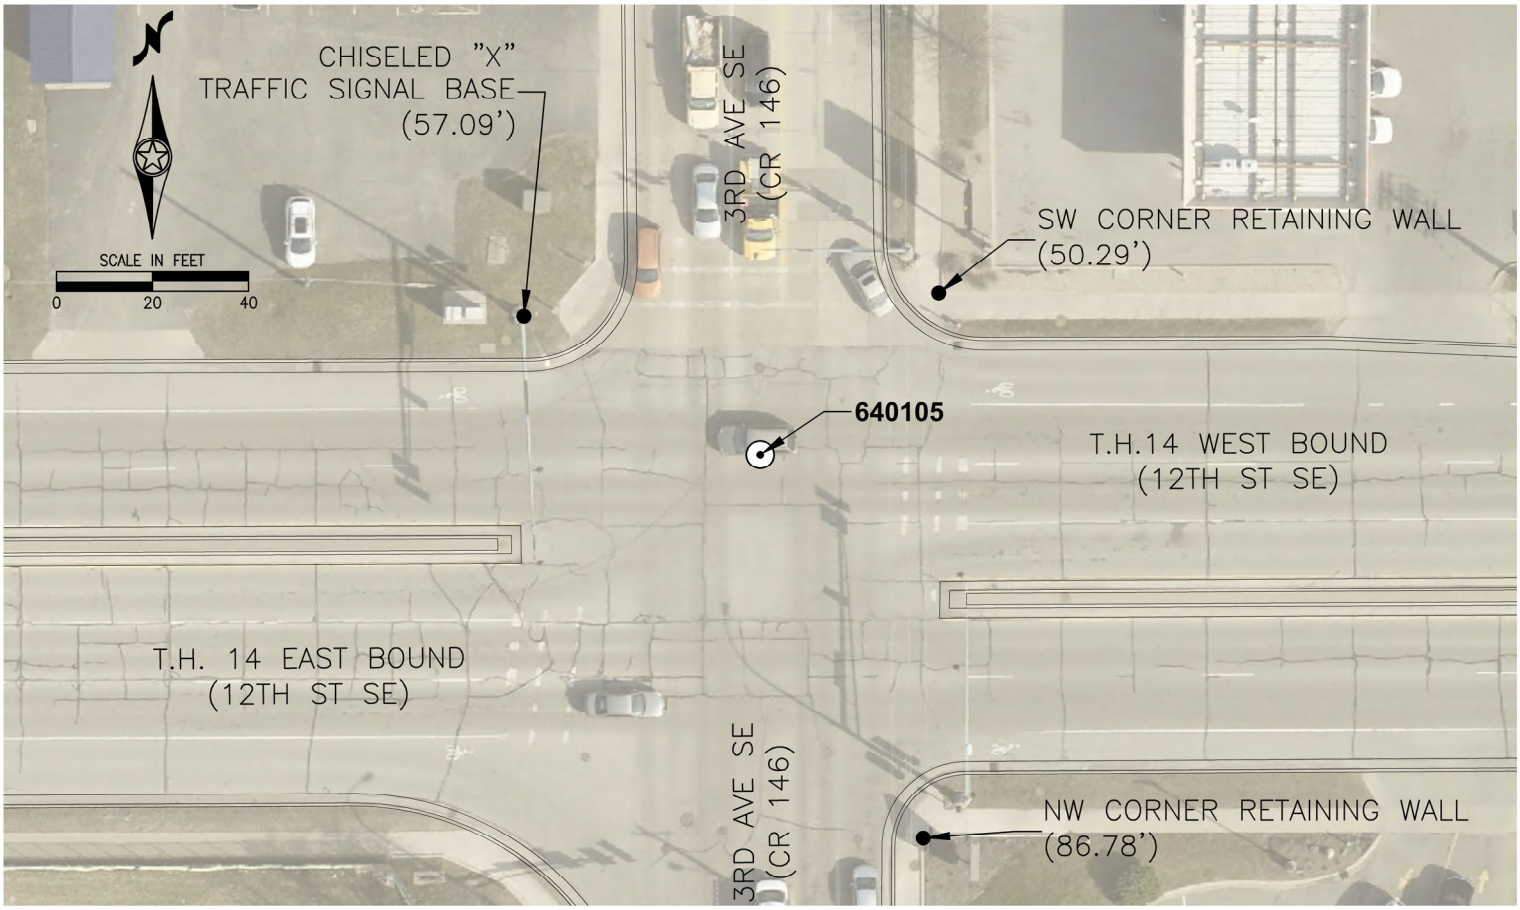

Statement of Evidence relative to this corner location is on back of page.

License No. 57072

☒ County Surveyor

☐ Deputy County Surveyor

☐ Land Surveyor

I hereby certify that this plan, survey or report was prepared by me or under my direct supervision and is correct and complete to the best of my knowledge and belief and that I am a duly Licensed Land Surveyor under the laws of the State of Minnesota.

Eric C. Stemmer
Signature

September 16, 2025
Date