Index No. 651005

CERTIFICATE OF LOCATION OF GOVERNMENT CORNER

Southwest Corner of Section 10 Township 106 N Range 15 W 5th P.M.


STATE OF MINNESOTA, County of Olmsted
At the corner location shown on the sketch:

☒ On June 30, 2026 found a Cast Iron Monument (bottom), laying flat at surface. Corner disturbed during waterway reconstruction.

☐ left monument as found, ☐ lowered monument, ☒ removed monument (explain)

☒ On June 30, 2026 set a Cast Iron Cap on Telspar Pipe up 0.2 feet. Corner falls in common corner between fields.

Sketch of Reference Ties

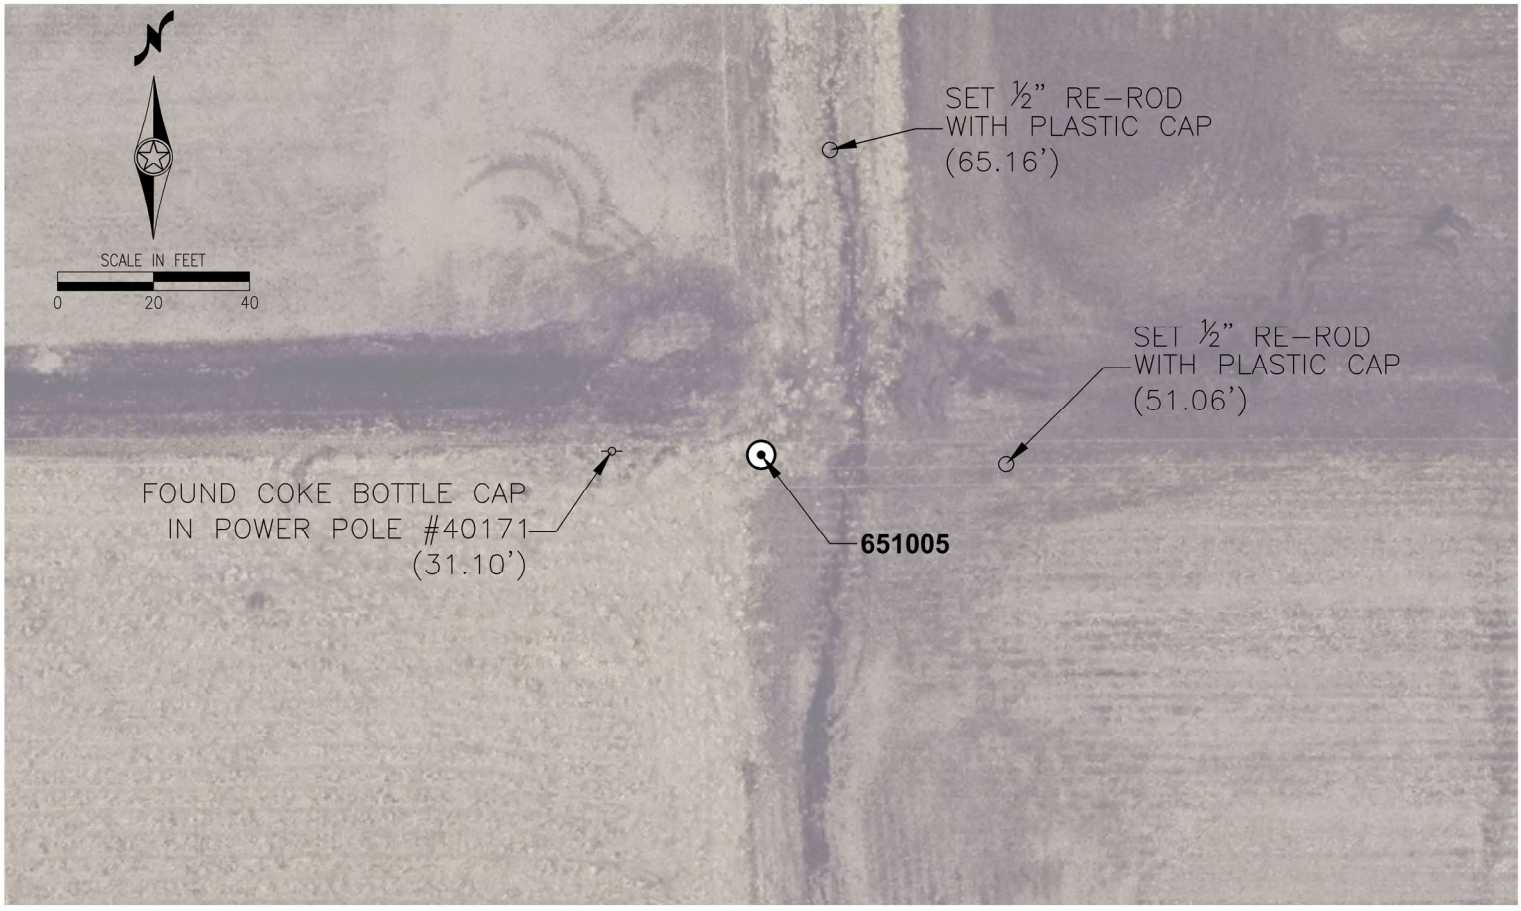

For Statement of Evidence Information, Please Contact the Olmsted County Surveyor's Office.

License No. 57072

☒ County Surveyor

☐ Deputy County Surveyor

☐ Land Surveyor

I hereby certify that this plan, survey or report was prepared by me or under my direct supervision and is correct and complete to the best of my knowledge and belief and that I am a duly Licensed Land Surveyor under the laws of the State of Minnesota.

Eric C. Stenman
Signature

October 16, 2026
Date