Index No. 651306

CERTIFICATE OF LOCATION OF GOVERNMENT CORNER

West Quarter Corner of Section 13 Township 106 N Range 15 W 5th P.M.


STATE OF MINNESOTA, County of Olmsted
At the corner location shown on the sketch:

☒ On June 10, 2026 found a Brass Disc with Punchmark at surface. Corner falls 7.9 feet north of centerline of C.S.A.H. NO. 25 and in centerline of 70TH AVE SW.

☒ left monument as found, ☐ lowered monument, ☐ removed monument (explain)

☐ On _____ set a _____

Sketch of Reference Ties

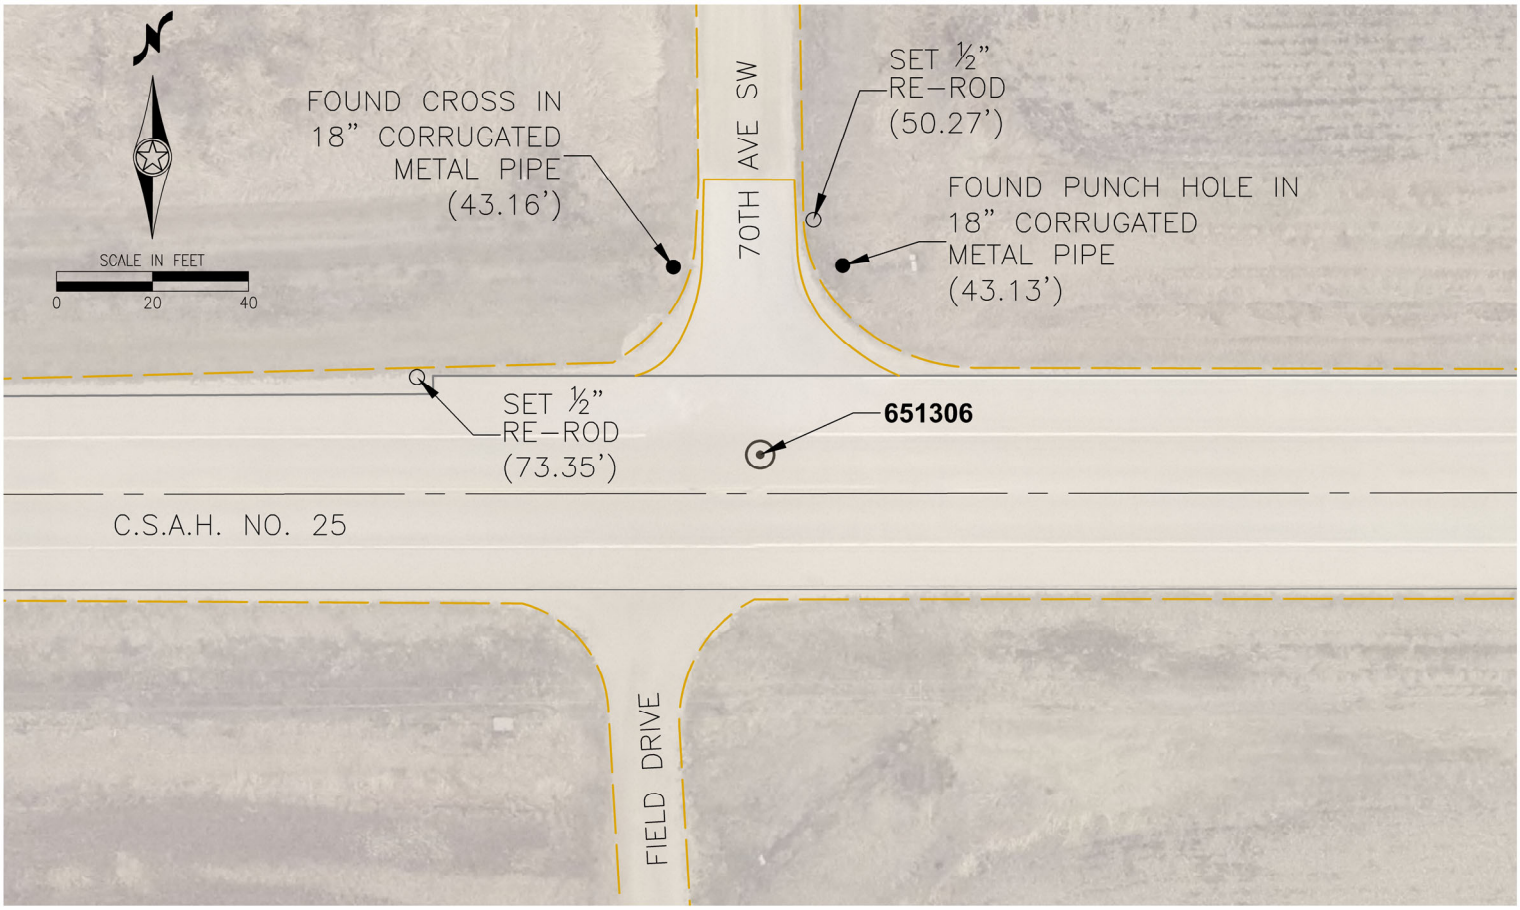

For Statement of Evidence Information, Please Contact the Olmsted County Surveyor's Office.

License No. 57072

☒ County Surveyor

☐ Deputy County Surveyor

☐ Land Surveyor

I hereby certify that this plan, survey or report was prepared by me or under my direct supervision and is correct and complete to the best of my knowledge and belief and that I am a duly Licensed Land Surveyor under the laws of the State of Minnesota.

Eric C. Stemmer
Signature

June 16, 2026
Date