Index No. 652805

CERTIFICATE OF LOCATION OF GOVERNMENT CORNER

Southwest Corner of Section 28 Township 106 N Range 15 W 5th P.M.


STATE OF MINNESOTA, County of Olmsted
At the corner location shown on the sketch:

☒ On June 24, 2026 found a 1" Square Pipe with Aluminum Cap. Removed for construction.

☐ left monument as found, ☐ lowered monument, ☒ removed monument (explain)

☒ On July 29, 2026 set a 1" Square Pipe with Aluminum Cap at surface. Corner falls in centerline of C.S.A.H. NO. 3, in centerline of C.S.A.H. NO. 17 west, and in centerline of 50TH ST SW.

Sketch of Reference Ties

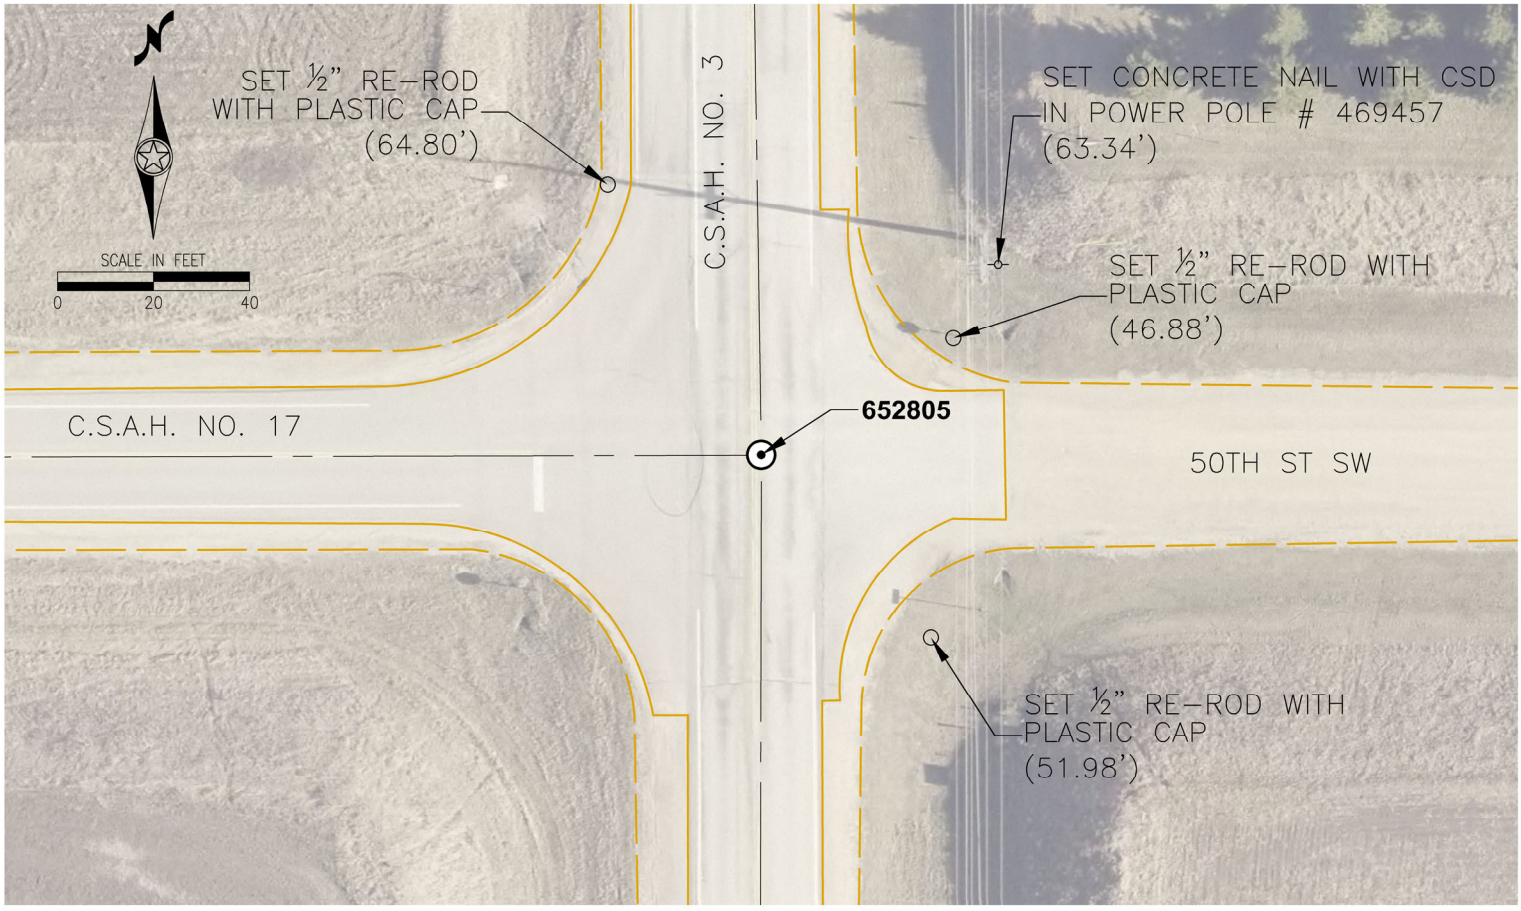

For Statement of Evidence Information, Please Contact the Olmsted County Surveyor's Office.

License No. 57072

☒ County Surveyor

☐ Deputy County Surveyor

☐ Land Surveyor

I hereby certify that this plan, survey or report was prepared by me or under my direct supervision and is correct and complete to the best of my knowledge and belief and that I am a duly Licensed Land Surveyor under the laws of the State of Minnesota.

Eric C. Stemmer
Signature

September 10, 2026
Date