Index No. 653306

CERTIFICATE OF LOCATION OF GOVERNMENT CORNER

West Quarter Corner of Section 33 Township 106 N Range 15 W 5th P.M.


STATE OF MINNESOTA, County of Olmsted
At the corner location shown on the sketch:

☒ On June 24, 2026 found a 1" Square Pipe with Aluminum Cap. Removed for construction.

☐ left monument as found, ☐ lowered monument, ☒ removed monument (explain)

☒ On July 03, 2026 set a 1" Square Pipe with Aluminum Cap at surface. Corner falls in centerline of C.S.A.H. NO. 3 and 20 feet south of centerline of driveway west.

Sketch of Reference Ties

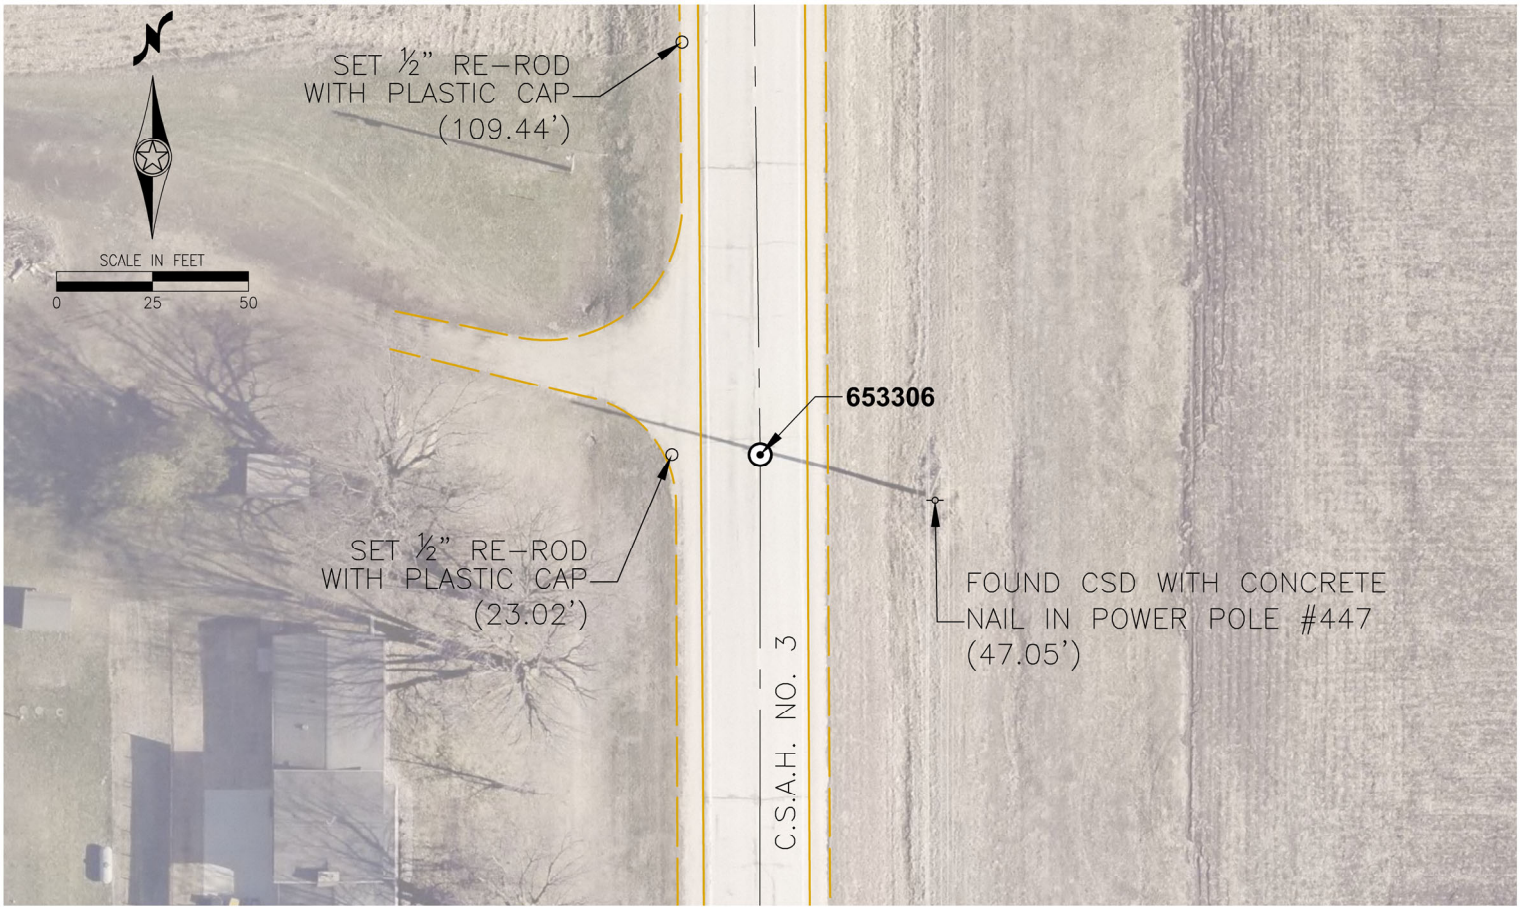

For Statement of Evidence Information, Please Contact the Olmsted County Surveyor's Office.

License No. 57072

☒ County Surveyor

☐ Deputy County Surveyor

☐ Land Surveyor

I hereby certify that this plan, survey or report was prepared by me or under my direct supervision and is correct and complete to the best of my knowledge and belief and that I am a duly Licensed Land Surveyor under the laws of the State of Minnesota.

Eric C. Stemmer
Signature

September 10, 2026
Date