Index No. 710704

CERTIFICATE OF LOCATION OF GOVERNMENT CORNER

South Quarter Corner of Section 07 Township 107 N Range 11 W 5th P.M.


STATE OF MINNESOTA, County of Olmsted
At the corner location shown on the sketch:

☒ On September 19, 2025 found No monument due to construction.

☐ left monument as found, ☐ lowered monument, ☐ removed monument (explain)

☒ On September 24, 2025 set a 1" Square Pipe with Aluminum Cap at surface. Corner falls 14.5 feet south of centerline of C.S.A.H. NO. 2, 1.0 feet west of centerline of C.S.A.H. NO. 7 south, and in line with fence north.

Sketch of Reference Ties

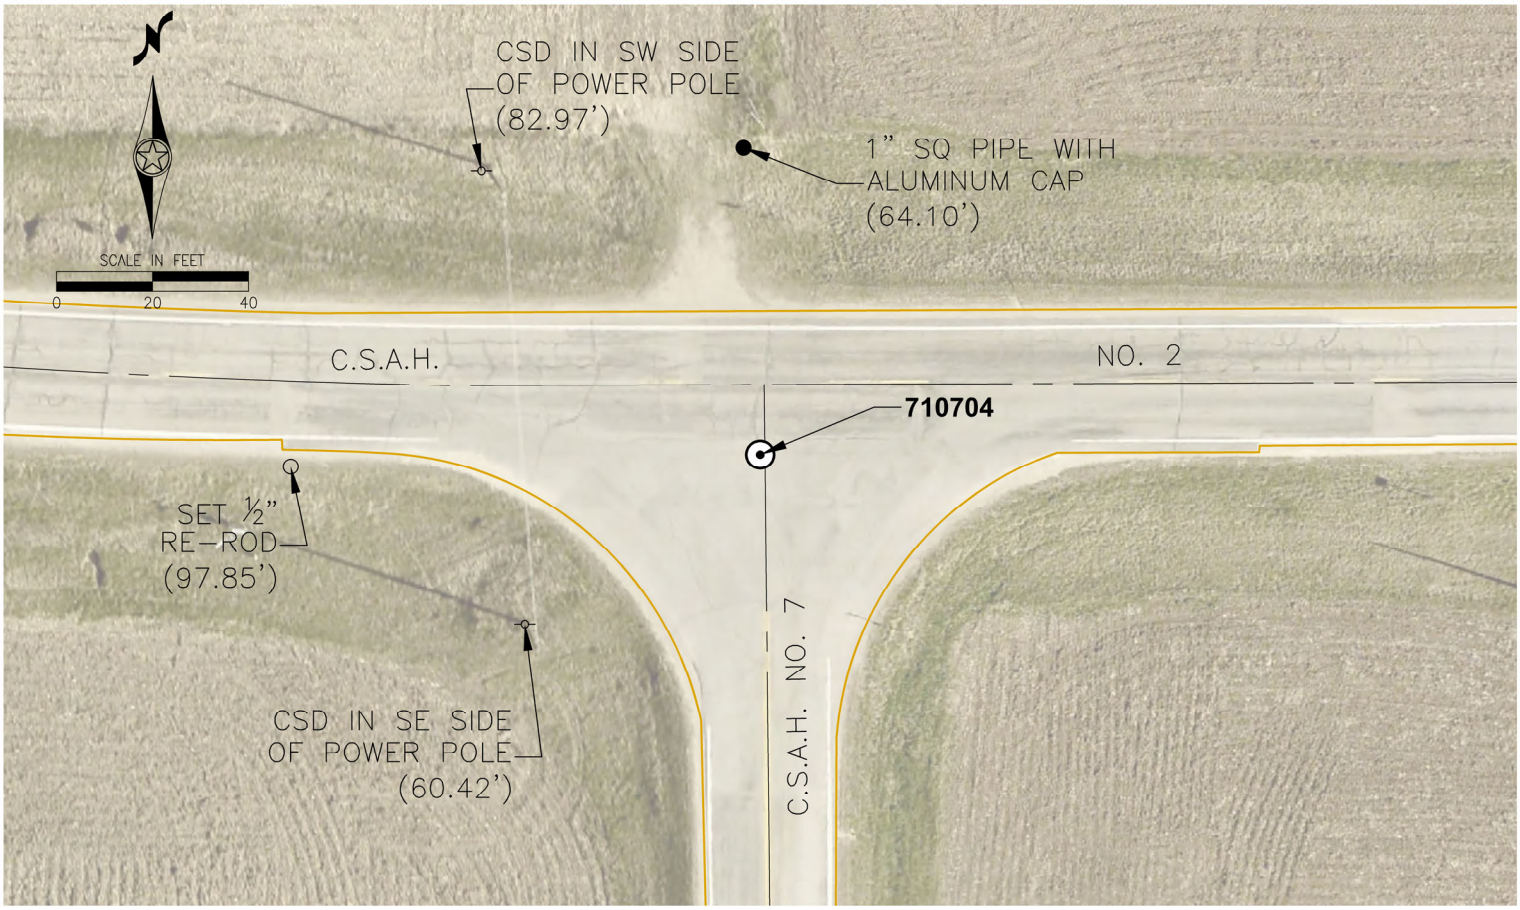

For Statement of Evidence Information, Please Contact the Olmsted County Surveyor's Office.

License No. 57072

☒ County Surveyor

☐ Deputy County Surveyor

☐ Land Surveyor

I hereby certify that this plan, survey or report was prepared by me or under my direct supervision and is correct and complete to the best of my knowledge and belief and that I am a duly Licensed Land Surveyor under the laws of the State of Minnesota.

Eric C. Stemmer
Signature

September 25, 2025
Date