Index No. 740604

CERTIFICATE OF LOCATION OF GOVERNMENT CORNER

South Quarter Corner of Section 06 Township 107 N Range 14 W 5th P.M.


STATE OF MINNESOTA, County of Olmsted
At the corner location shown on the sketch:

☒ On October 20, 2025 found No monument at corner due to construction.

☐ left monument as found, ☐ lowered monument, ☐ removed monument (explain)

☒ On October 20, 2025 set a 1" Square Pipe with Aluminum Cap at surface. Corner falls 0.45 feet North of the north edge of southerly curb lip in SW quadrant of roundabout.

Sketch of Reference Ties

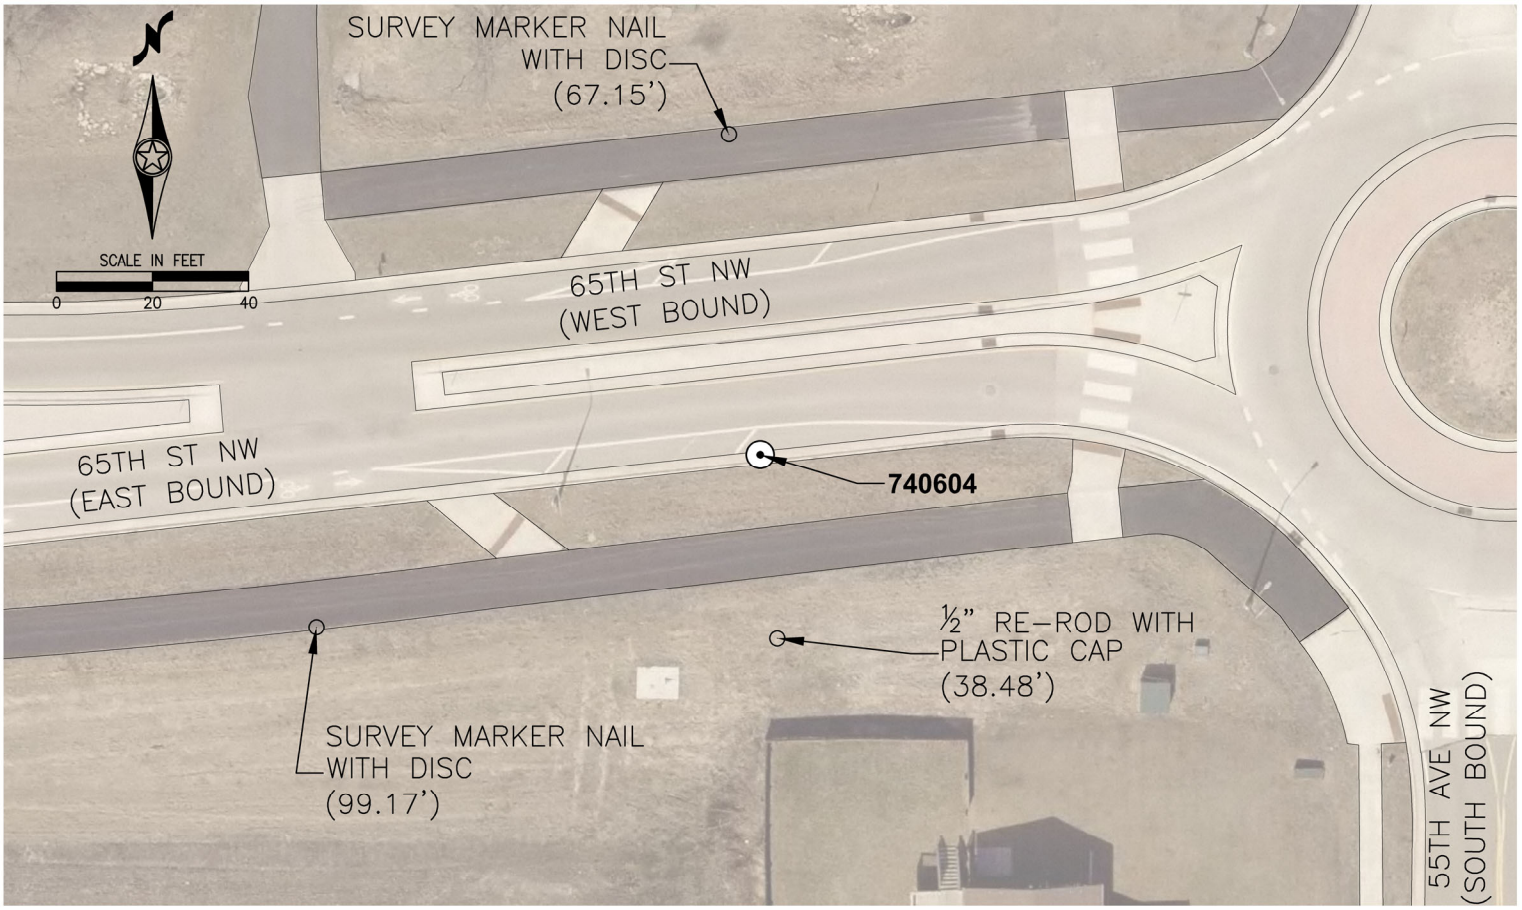

For Statement of Evidence Information, Please Contact the Olmsted County Surveyor's Office.

License No. 57072

☒ County Surveyor

☐ Deputy County Surveyor

☐ Land Surveyor

I hereby certify that this plan, survey or report was prepared by me or under my direct supervision and is correct and complete to the best of my knowledge and belief and that I am a duly Licensed Land Surveyor under the laws of the State of Minnesota.

Eric C. Stemmer
Signature

October 29, 2025
Date