Index No. 740605

CERTIFICATE OF LOCATION OF GOVERNMENT CORNER

Southwest Corner of Section 06 Township 107 N Range 14 W 5th P.M.


STATE OF MINNESOTA, County of Olmsted
At the corner location shown on the sketch:

☒ On October 10, 2025 found No monument at corner due to construction.

☐ left monument as found, ☐ lowered monument, ☐ removed monument (explain)

☒ On October 10, 2025 set a 1" Square Pipe with Aluminum Cap at surface. Corner falls in centerline of 60th Ave NW and 12.5 feet south of centerline of 65th St NW (east).

Sketch of Reference Ties

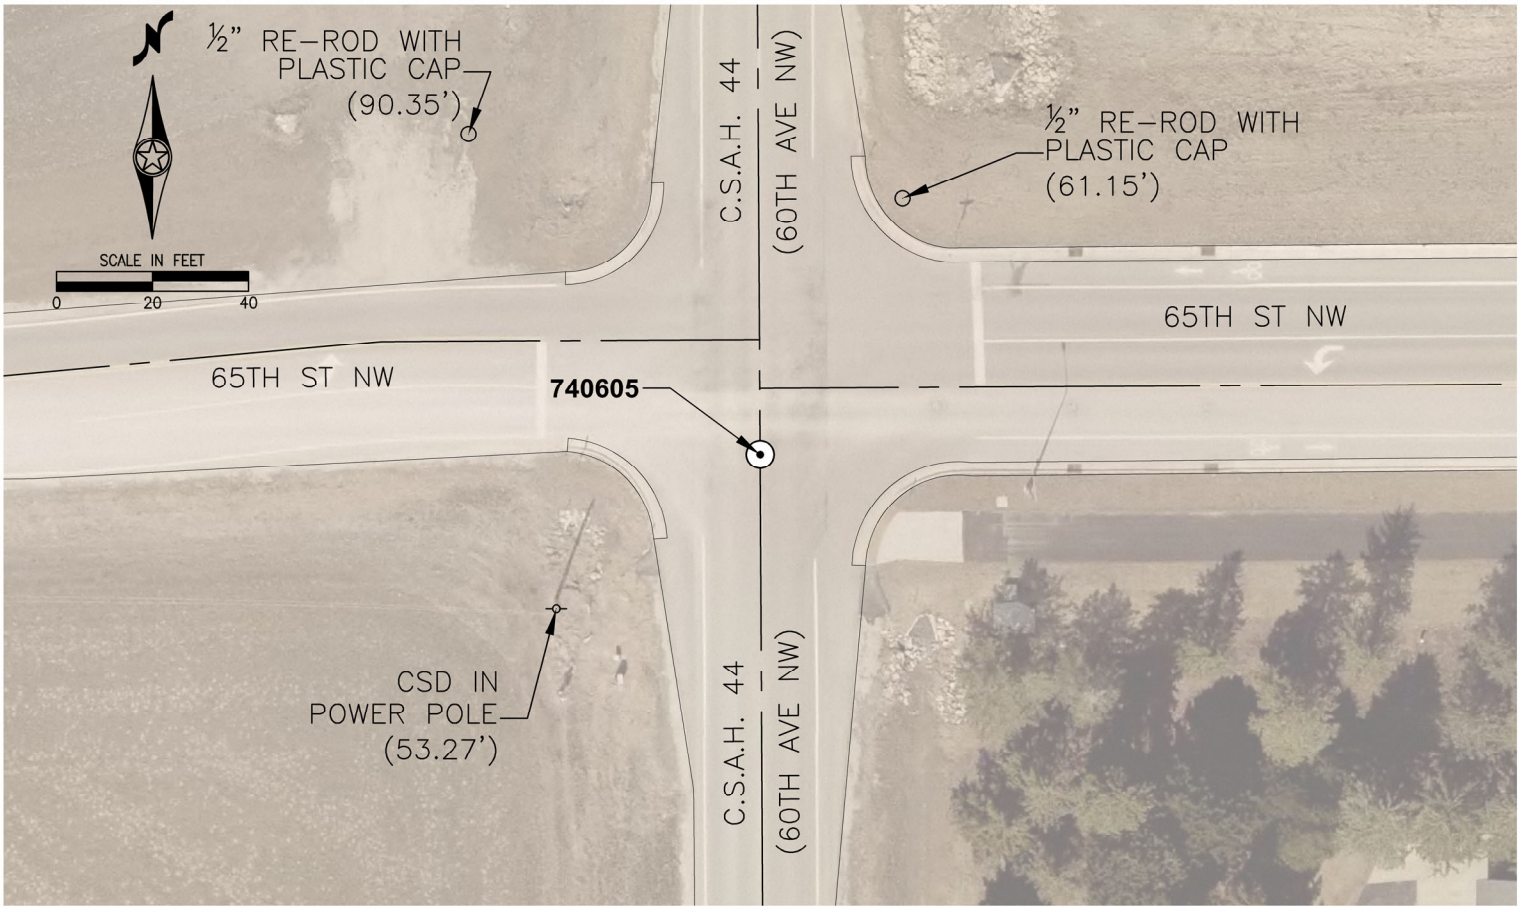

For Statement of Evidence Information, Please Contact the Olmsted County Surveyor's Office.

License No. 57072

☒ County Surveyor

☐ Deputy County Surveyor

☐ Land Surveyor

I hereby certify that this plan, survey or report was prepared by me or under my direct supervision and is correct and complete to the best of my knowledge and belief and that I am a duly Licensed Land Surveyor under the laws of the State of Minnesota.

Eric C. Stemmer
Signature

October 13, 2025
Date