Index No. 830705

CERTIFICATE OF LOCATION OF GOVERNMENT CORNER

Southwest Corner of Section 07 Township 108 N Range 13 W 5th P.M.


STATE OF MINNESOTA, County of Olmsted
At the corner location shown on the sketch:

☒ On October 13, 2025 found a 1" Square Pipe with Aluminum Cap at surface. Corner falls 8.0 feet south of centerline of C.S.A.H. NO. 12 and 74.0 feet east of centerline of driveway north.

☒ left monument as found, ☐ lowered monument, ☐ removed monument (explain)

☐ On _____ set a _____

Sketch of Reference Ties

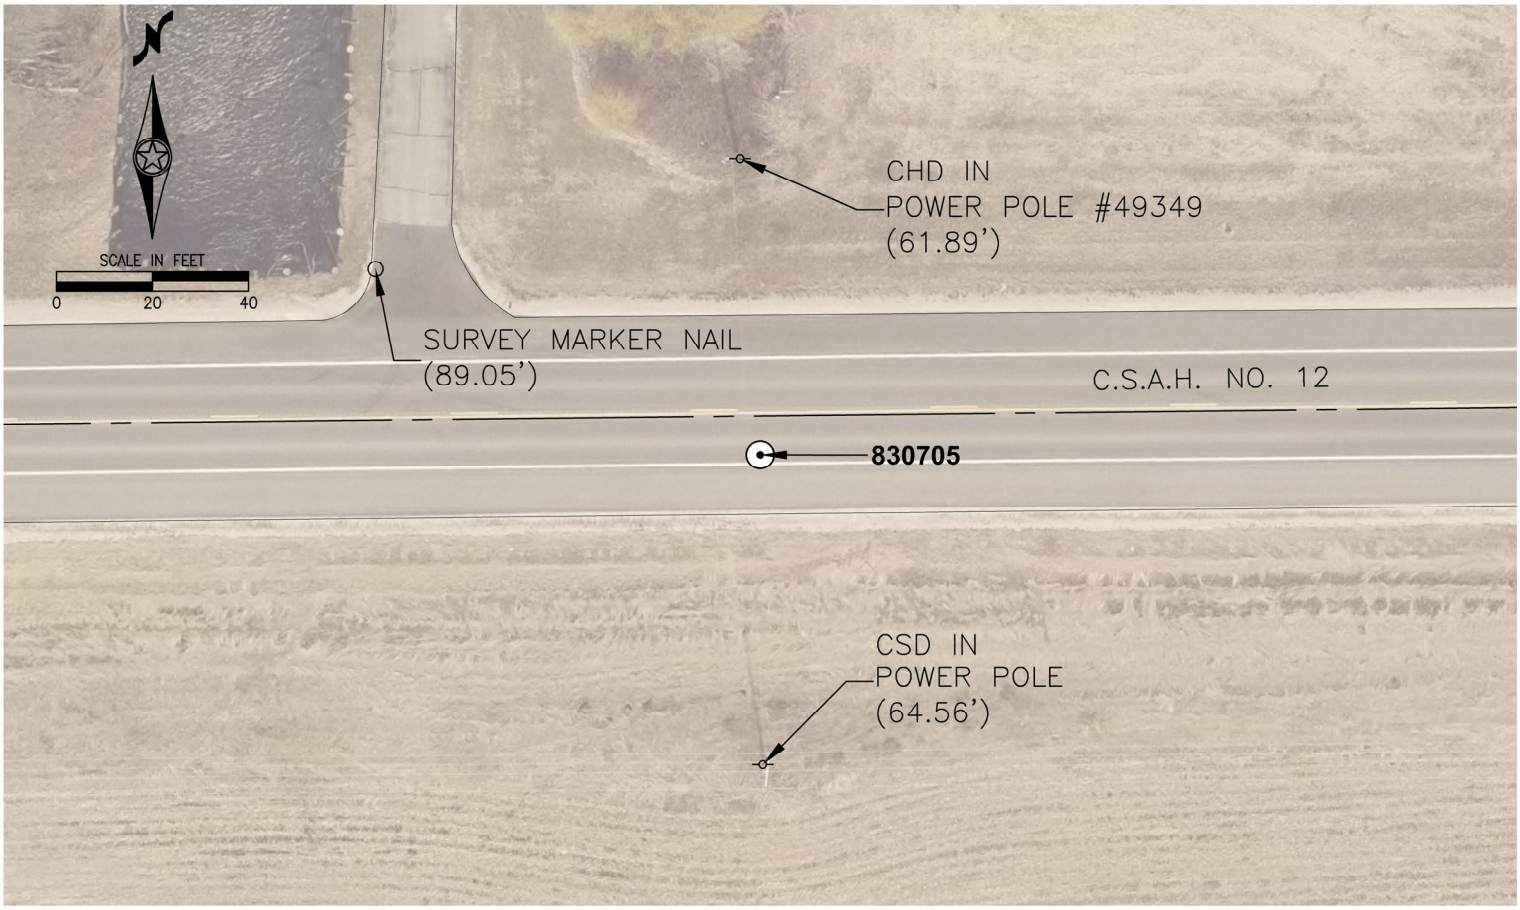

For Statement of Evidence Information, Please Contact the Olmsted County Surveyor's Office.

License No. 57072

☒ County Surveyor

☐ Deputy County Surveyor

☐ Land Surveyor

I hereby certify that this plan, survey or report was prepared by me or under my direct supervision and is correct and complete to the best of my knowledge and belief and that I am a duly Licensed Land Surveyor under the laws of the State of Minnesota.

Eric C. Stemmer
Signature

October 14, 2025
Date