Index No. 832304

CERTIFICATE OF LOCATION OF GOVERNMENT CORNER

South Quarter Corner of Section 23 Township 108 N Range 13 W 5th P.M.


STATE OF MINNESOTA, County of Olmsted
At the corner location shown on the sketch:

☒ On September 04, 2026 found a Copper Plug with Punchmark at surface. Updated ties and took photos.

☒ left monument as found, ☐ lowered monument, ☐ removed monument (explain)

☐ On _____ set a _____

Sketch of Reference Ties

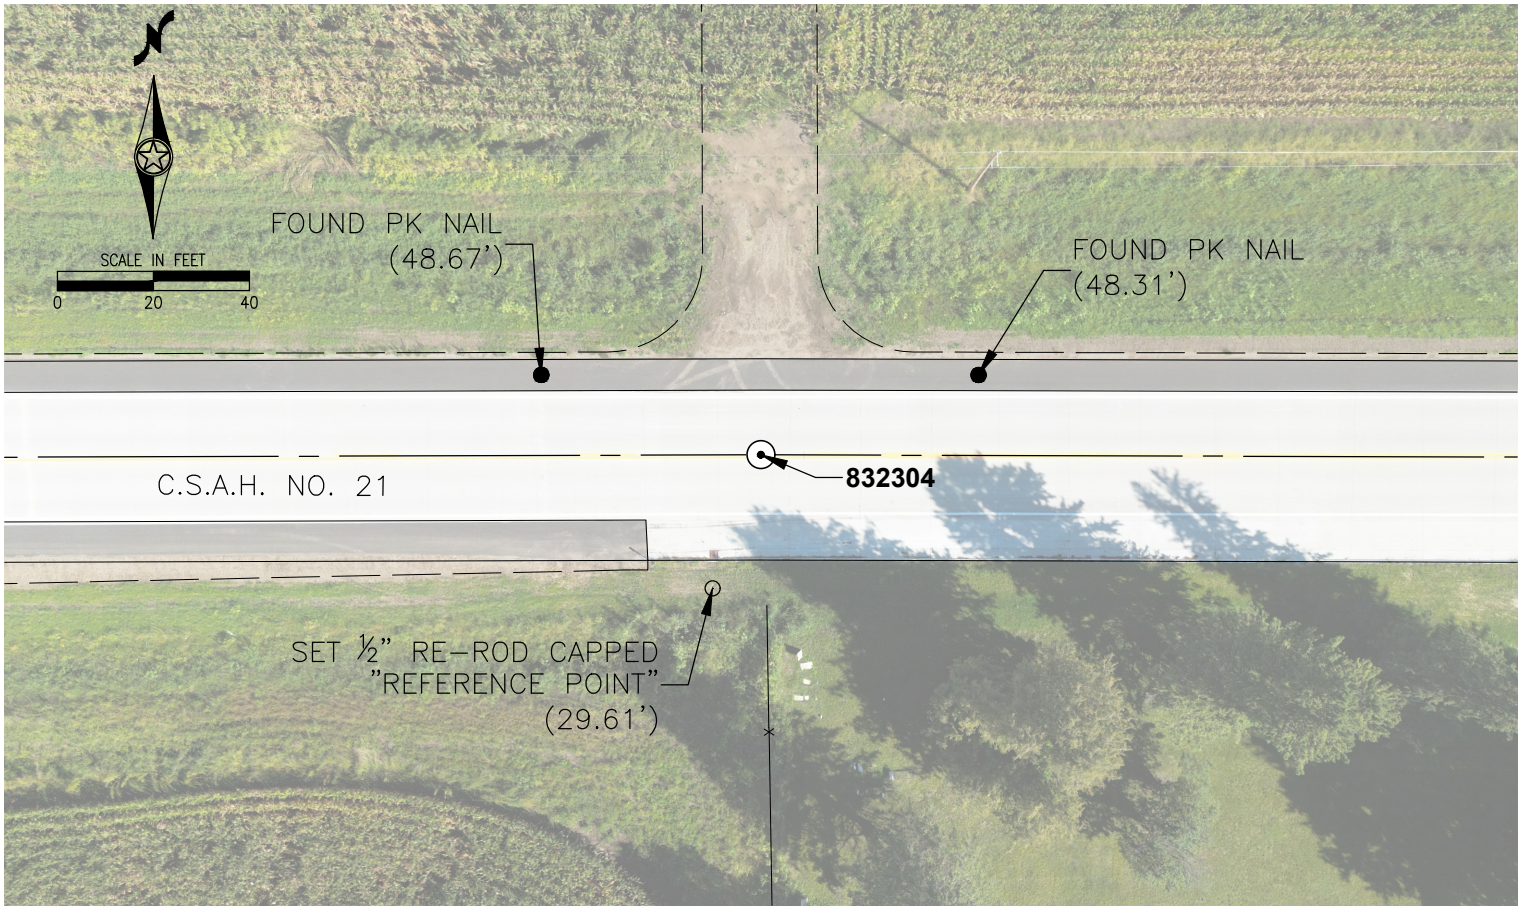

For Statement of Evidence Information, Please Contact the Olmsted County Surveyor's Office.

License No. 57072

☒ County Surveyor

☐ Deputy County Surveyor

☐ Land Surveyor

I hereby certify that this plan, survey or report was prepared by me or under my direct supervision and is correct and complete to the best of my knowledge and belief and that I am a duly Licensed Land Surveyor under the laws of the State of Minnesota.

Eric C. Stenman
Signature

September 18, 2026
Date

Index No. 832304

CERTIFICATE OF LOCATION OF GOVERNMENT CORNER

South Quarter Corner of Section 23 Township 108 N Range 13 W 5th P.M.


STATE OF MINNESOTA, County of Olmsted
At the corner location shown on the sketch:

☒ On July 28, 2026 found No monument at corner due to construction.

☐ left monument as found, ☐ lowered monument, ☐ removed monument (explain)

☒ On July 28, 2026 set a Copper Plug with Punchmark at surface. Corner falls in centerline of C.S.A.H. NO. 21 and 1.5 feet west of fence south.

Sketch of Reference Ties

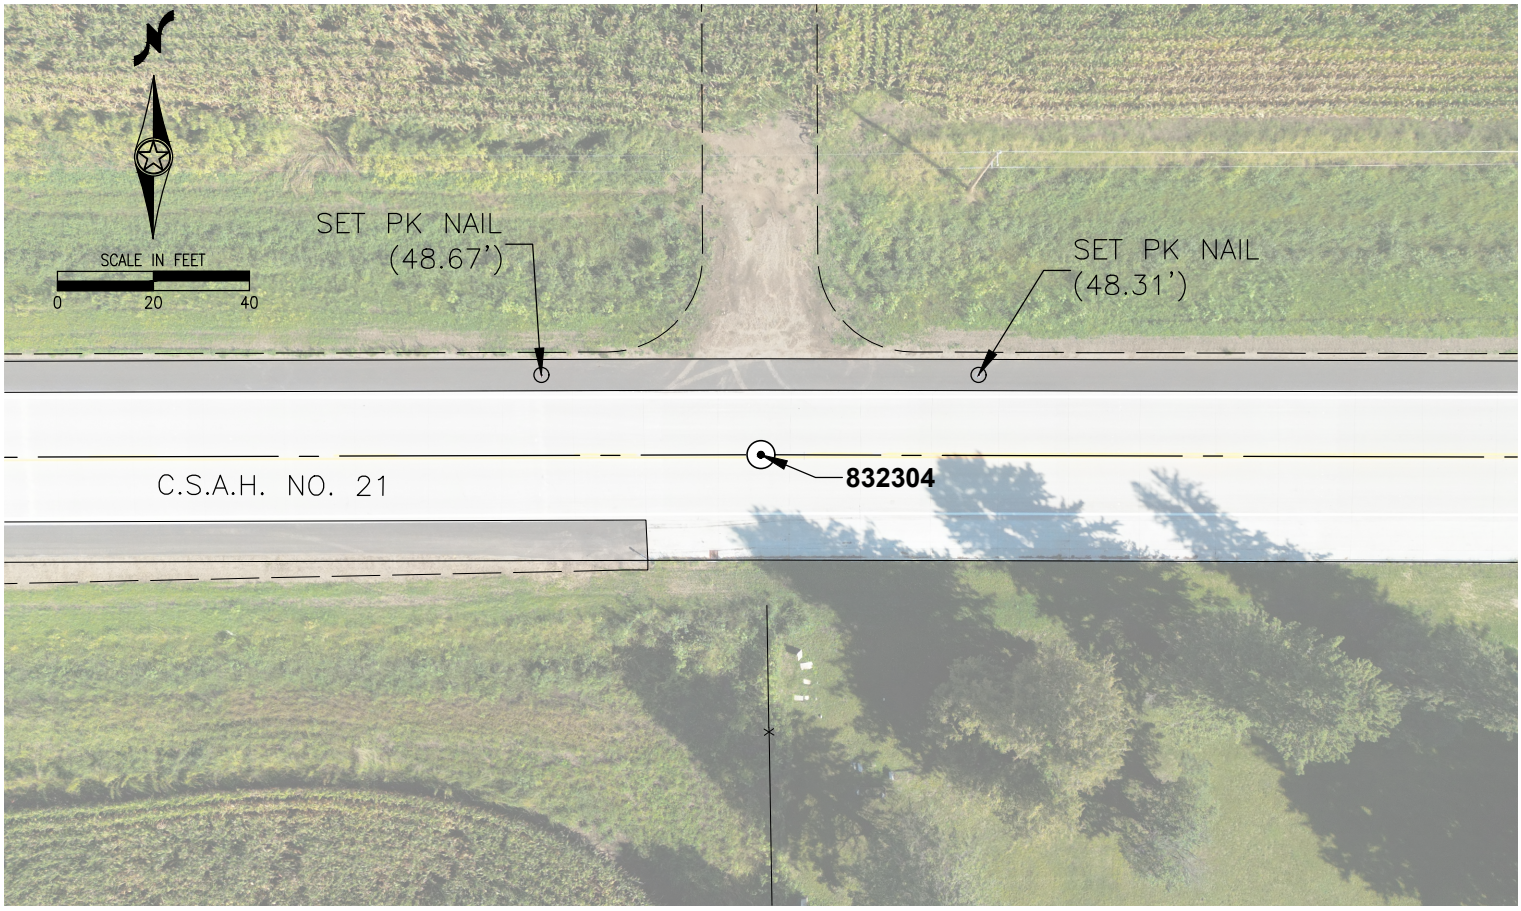

For Statement of Evidence Information, Please Contact the Olmsted County Surveyor's Office.

License No. 57072

☒ County Surveyor

☐ Deputy County Surveyor

☐ Land Surveyor

I hereby certify that this plan, survey or report was prepared by me or under my direct supervision and is correct and complete to the best of my knowledge and belief and that I am a duly Licensed Land Surveyor under the laws of the State of Minnesota.

Eric C. Stenman
Signature

September 18, 2026
Date