Index No. 840204

CERTIFICATE OF LOCATION OF GOVERNMENT CORNER

South Quarter Corner of Section 02 Township 108 N Range 14 W 5th P.M.


STATE OF MINNESOTA, County of Olmsted
At the corner location shown on the sketch:

☒ On September 24, 2026 found a 1" Square Pipe disturbed.

☐ left monument as found, ☐ lowered monument, ☒ removed monument (explain)

☒ On September 29, 2026 set a 1" Square Pipe with Aluminum Cap at surface. Corner falls 12.0 feet east of centerline of 3RD AVE NW and 11.0 feet north of driveway east.

Sketch of Reference Ties

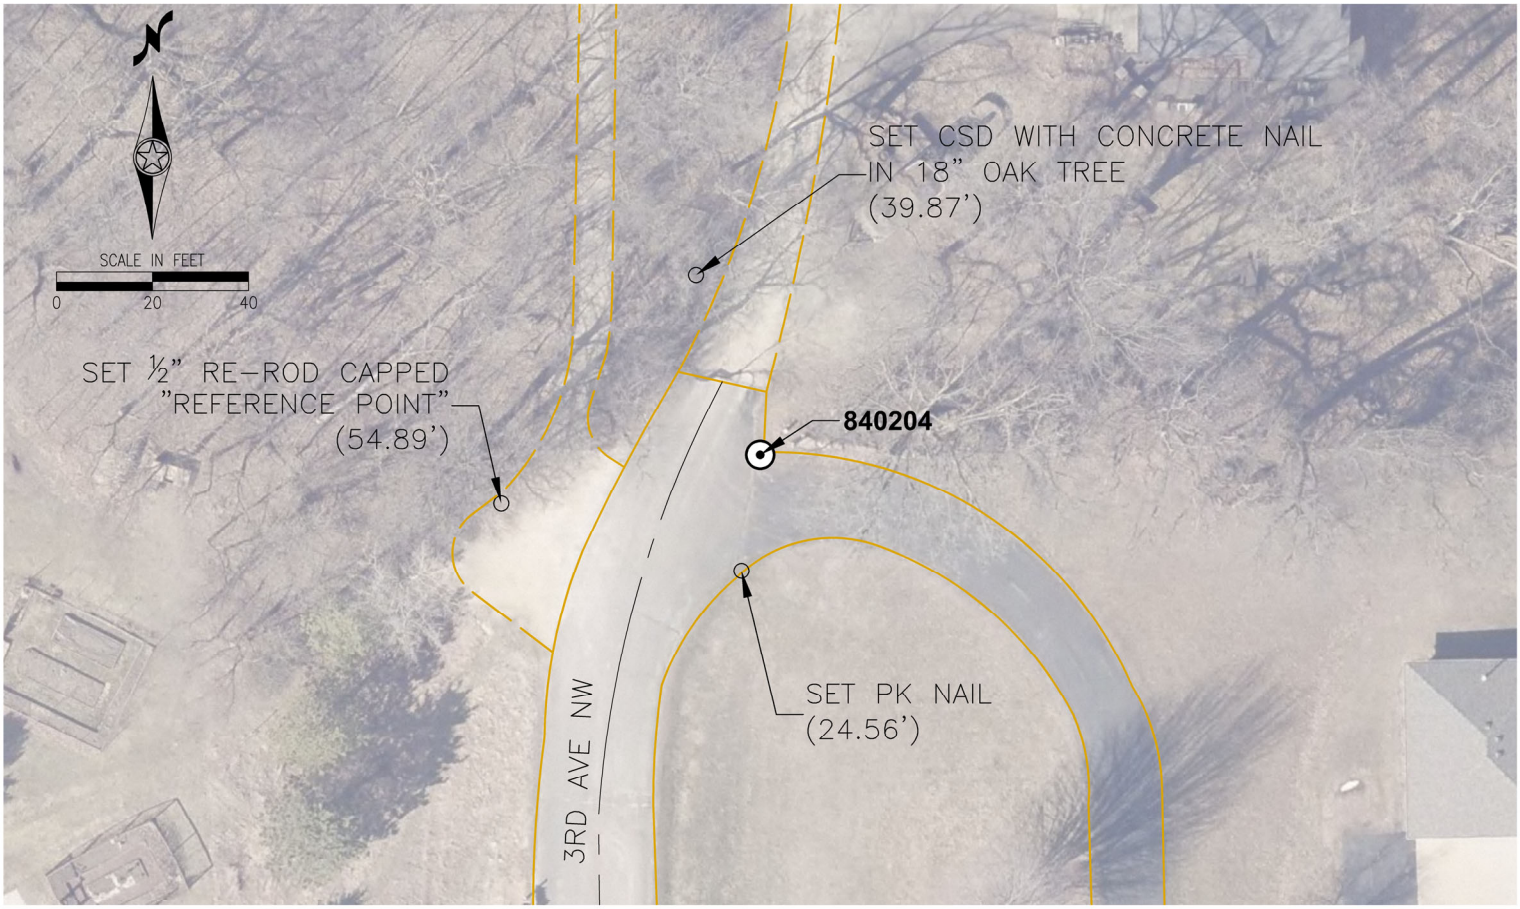

For Statement of Evidence Information, Please Contact the Olmsted County Surveyor's Office.

License No. 57072

☒ County Surveyor

☐ Deputy County Surveyor

☐ Land Surveyor

I hereby certify that this plan, survey or report was prepared by me or under my direct supervision and is correct and complete to the best of my knowledge and belief and that I am a duly Licensed Land Surveyor under the laws of the State of Minnesota.

Eric C. Stemmer
Signature

September 30, 2026
Date