Index No. 841106

CERTIFICATE OF LOCATION OF GOVERNMENT CORNER

West Quarter Corner of Section 11 Township 108 N Range 14 W 5th P.M.


STATE OF MINNESOTA, County of Olmsted
At the corner location shown on the sketch:

☒ On September 30, 2026 found a 1" Square Pipe disturbed.

☐ left monument as found, ☐ lowered monument, ☒ removed monument (explain)

☒ On October 05, 2026 set a 1" Square Pipe with Aluminum Cap at surface. Updated ties and took photos.

Sketch of Reference Ties

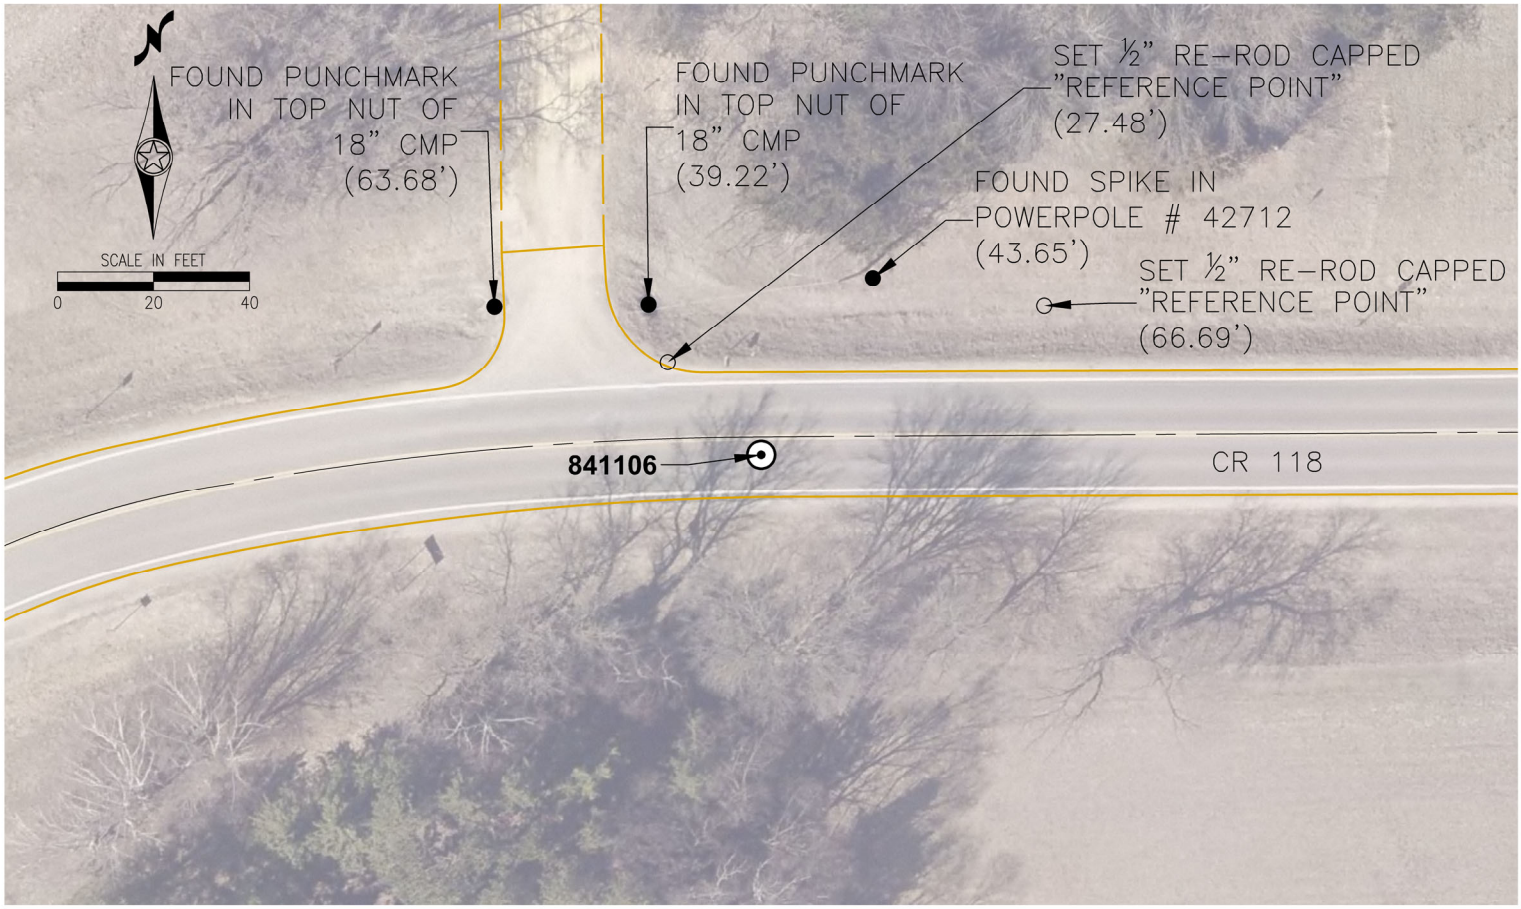

For Statement of Evidence Information, Please Contact the Olmsted County Surveyor's Office.

License No. 57072

☒ County Surveyor

☐ Deputy County Surveyor

☐ Land Surveyor

I hereby certify that this plan, survey or report was prepared by me or under my direct supervision and is correct and complete to the best of my knowledge and belief and that I am a duly Licensed Land Surveyor under the laws of the State of Minnesota.

Eric C. Stenman
Signature

October 06, 2026
Date