Index No. 843404

CERTIFICATE OF LOCATION OF GOVERNMENT CORNER

South Quarter Corner of Section 34 Township 108 N Range 14 W 5th P.M.


STATE OF MINNESOTA, County of Olmsted
At the corner location shown on the sketch:

☒ On September 09, 2025 found No monument at corner due to construction.

☐ left monument as found, ☐ lowered monument, ☐ removed monument (explain)

☒ On September 11, 2025 set a Telspar Pipe with Cast Iron Cap down 0.2 feet. Corner falls in roundabout and in line with centerlines of T.H. 63 and CR. NO. 112.

Sketch of Reference Ties

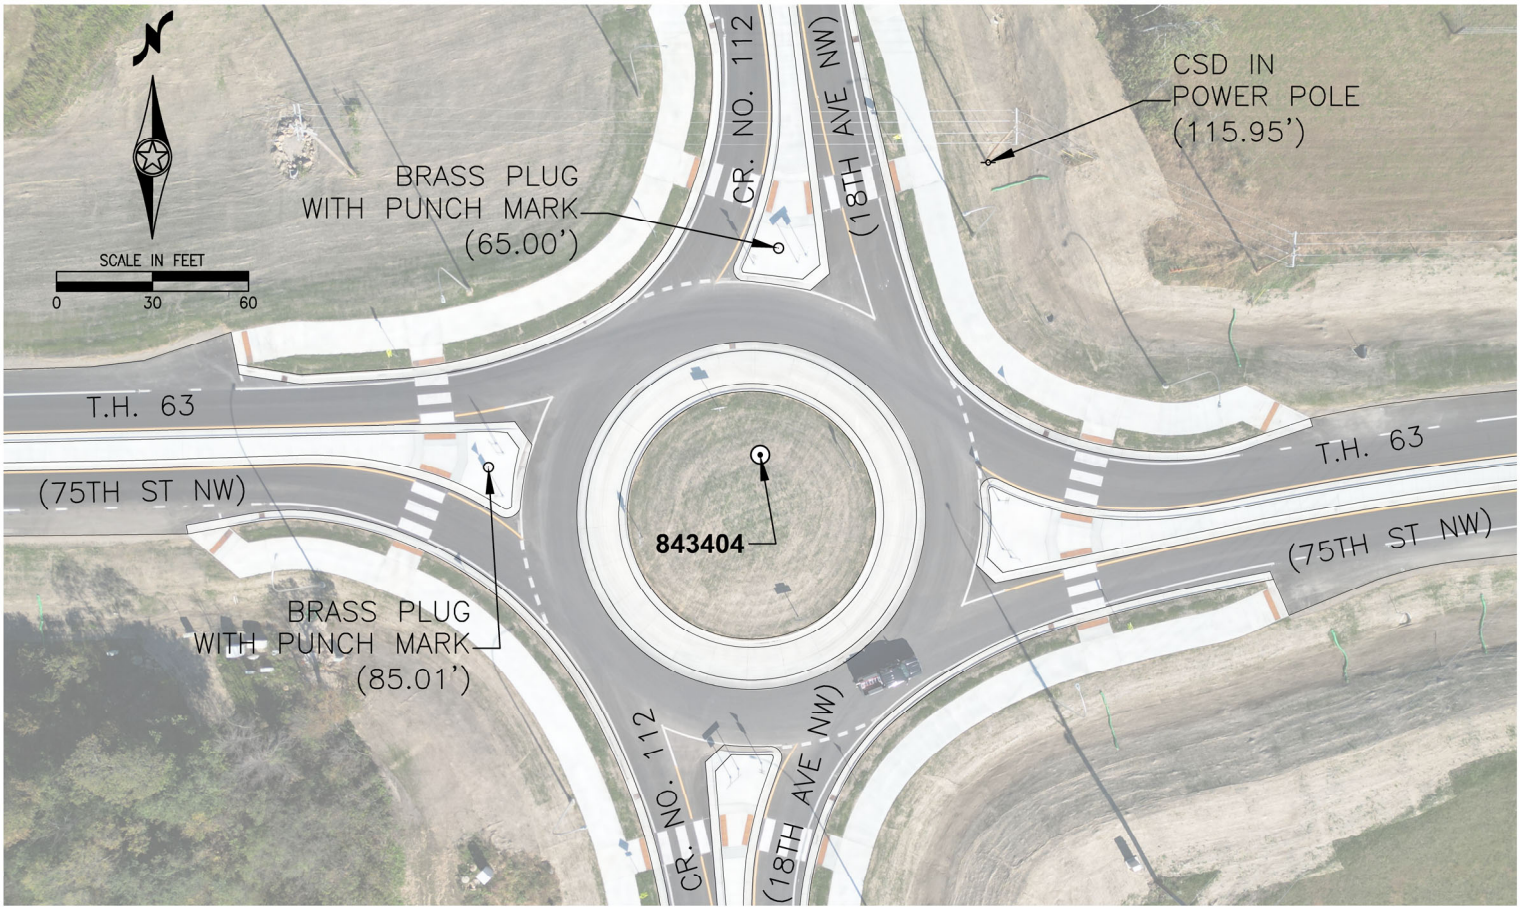

For Statement of Evidence Information, Please Contact the Olmsted County Surveyor's Office.

License No. 57072

☒ County Surveyor

☐ Deputy County Surveyor

☐ Land Surveyor

I hereby certify that this plan, survey or report was prepared by me or under my direct supervision and is correct and complete to the best of my knowledge and belief and that I am a duly Licensed Land Surveyor under the laws of the State of Minnesota.

Eric C. Stemmer
Signature

October 13, 2025
Date