L 6-28-71 set C/M over 5/8" x 11" rod and org stone pottery (1)
#44040
Section corner north 4-5 Iti Forest 104-14.
5-1898 Hunter P343 no337 L4 HD Morse & others
No evidence of corner. Meas 8.25 chs west of fence line
north on L 1/4 line 32. as found to be in 1857 when all corners
were standing. then found grubb hob of NE BT which put
location. where on digging found remains of old stake. Mr Carlson
owns stake stood some time ~~who~~ further north or suggested a
tree as SE BT 893 lks from govt corner. It now being 913 lks
set stone 3 x 6 x 14 with glass and broken pottery under stone
against protests of Mr Carlson at org stake set.
-16 east set temp stake N & L 20,36 1/4 (1343.92)
-16 south set unmarked stake N & L 19,87 1/2 by request.
-16 Center NW 1/4 4 set stake miles land
- meas east to stone set 4x10x16 8.25 chs on line NW 4 & SE 32
549.5

4-1906 Ch Armstrong P104 B. S NW¼ 4. AL Bruch.
found stone and pottery. P 343
- Meas east 20.37 to stone boulder set M & L. N¼4. (1344.42
a stone found as recorded
-16 south set stone boulder 20.13 north of W¼ 4. (1328.58
- Meas south to W¼ 4 stone 39.63 total. (2615.58.

12-1915 J Kerr P2½ B. field book -11 P23. L31 J Burn atty.
found stone easily at L¼ 32. stone set by Hauta P343
- Meas west to L 31-32 set ⅓ way to S N 31. 2636.66.
did not look for N W Corner at that time.

1940 B 112 P3 C H D. assumed corner. 5/8" reinf rod set.
center Sec 6 M which lies 3' S of 24" elm N. 30.83
tp in cor F P SW 41.45 Meas L. 2614.9 to
Elec in 24" oak. last oak on West W NW. 87.9. ¼ 4-5 found.
- Meas east 2677.98 Note corner could be west 9.85'
Note: Correct corner West ± 10' & ±2' N.

#440407

(2)

Card # 2. N. Sec Cor 4-5 Hts for 104-14.

1931. CHD B61 P7.

Controversy corner - assumed.

Record. 2688.84 - Book "B" P104 ch Armstrong

found stone at NW cor 4 & N 1/4 4 2687.85

- assumed corner could be west 9.85

1940 meas 2677.98 east

6-2-71 Co surv. proj. line and meas from S 1/4 31 over S 31-32 105-14 as done in 1915 by J Kerr. P242B. set nail at 2089.08 for area of N 4-5 104-14. and cont to 2614.08 for area of S 1/4 32 105-14

6-8-71 ran and meas entire line from iron at N 3-4. over.

N 1/4. both irons set by previous surveyors. set nails at 2141.45 and 2676.6.
6-25 dug and found S 1/4 32 recorded size limestone only some 6" of top gone and worn smooth by traffic. with amount of coal beneath stone and drag track on N side. stone found came. 3.65 N and 1.23 W of 2141.45
came. 15.4' S of line from west at sta 2632.0 or 17.92 east of 2614.08.
6-28-71 dug again for N-4-5 found recorded stone and crockery. 6' north of line from east at 2686.78 from N 1/4 - 544.1 east to stone found at S 1/4 32.
2673.83 west to N 1/4 5 ac set from cemetery notes - corner. 8.35' N of direct line S 1/4 31 over S 31-32. at 2087.93 E of-531-32

Card no 3. N 4-5 10 4-14 Hi Forest. (3)

#44040

Drive south To iron set as 1/4 4-5 2616.5 R2616.58

N 1/4 4. at 2686.78 and N 3-4 2687.8 R 2687.84.

indicates E-W very near but can't figure N-4-5 being 6' even north of direct line from east - no dispute about corner & pottery found at N-4-5


RP C/N over stone pottery and 5/8" x 11" rod.

2.6' N of center east-west roade. 2' west of Wedge road S.

- MHD disc on E side power pole up 2 # 11077	S 5° W	122.8
- center spout of old pump in mail box standard	S	60.55
- Center Geo B M post	NNE	31.23
- hard nail on S W side PP	NW	30.72
- 20 D m center S side 36" burr oak up 18"	W N W	18.0

(over

Meas N-4-5 104-14 west to S 31-32. 2088.93.
" " " " to N 1/4 5 2674.83.
" " " east to S 1/4 32 544.1

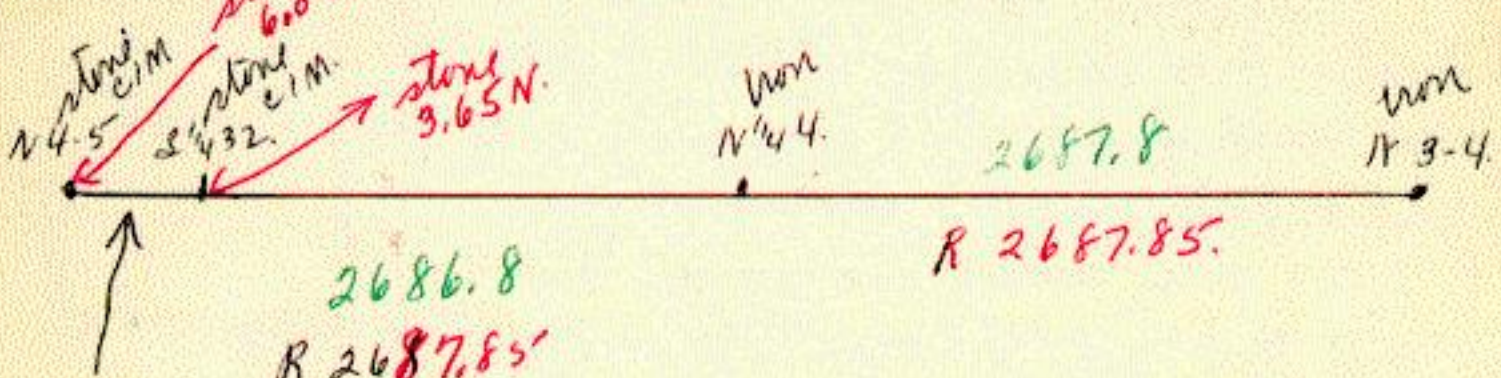

Gov't Notes Ball 1853

North between sections 4&5.
79.38 Intersected north boundary line 410 lks. west of 1/4 section post south of section 32. Set post.
Bur Oak 8in. N-88 E-59 lks.
Black Oak 10in. S-72 E-893 lks.