X 6-8-71 found iron 7-27-1979 Set a C I M. over the stone #440408 (1)

1/4 Corner. North 1/4 4 Hi Forest 104-14 2

5-1878 Hunter P343 No 337 S4 H D Morse & others
No corner ever set in orig survey
established corner N & L on north line Sec 4.
set stone N & L 40.72½ (2687.8½) 6 x 12 x 25 in center road.
-16 west set temp stake N & L 20.36¼ (134392
-16 south set stake N & L 19.94½ by agreement, not
by legal govt proportions.

4-1906 Ch Armstrong P164B S4 A L Bruch.
found recorded stone as corner. (344.42'
-16 west set stone N & L 20.37. To stone at N W cor 4.
-16 south set stone 19.65 (12969 chns 20.21 (1333.86 to cr Pst Center 4.

N¼ 4 104-14

5-1953 McGhee

found stone set 3/4" iron riser.

Hub 4' north of SW leg of windmill E.N.E 98.85.

Hub east side of fence. S. 74.7.

same ties for South section corner 32-33.

recopy one that is wrong later. ties belong to N¼ 4 104-14

County B166. stone 3/4" riser correct N¼ 4 not same ties as above. found stone 3' north of PI S 32-33.

~~NE cor 3 cone fence post east~~ gone to 11 ~~S E 48.4~~

NW cor " " " south still in place S ~~48.6~~ 33.2 B61 P6

Mean east 2689.0 Mean W. 2679.0


10-1940 C H D B 1/2 P4. Hub one stone mon. 3/4" rod riser RPs as McGhee above.

See J Kerr. B-3 P 30. found stone 31' N of one just and on line

#440408 (2)

Card # 2 North ¼ 4 High Forest 104-14

6-8-71 Co. surv. found ¾" iron riser in black top road
- 8" square conc post used as RP still in ditch still vertical.
RP to NW corner conc post (record CoHD 30.6) due L. 33.2'
- also found SW windmill leg down 10"±, could not find hub recorded by McGhee 5-1953 4' north of SW leg windmill.
- set ½" short rod exactly over point of angle leg. ><
Meas now. 97.28 NEly – iron 11.6 to center 10" well tube over rod & center well in line 1' west of main south door frame.
- SW corner house foundation. Level meas. SE 168.17
- Meas to east fence line school prop 409.3 east.
- record meas N¼ 4 east to L. 32-33. figures over. 494.5'

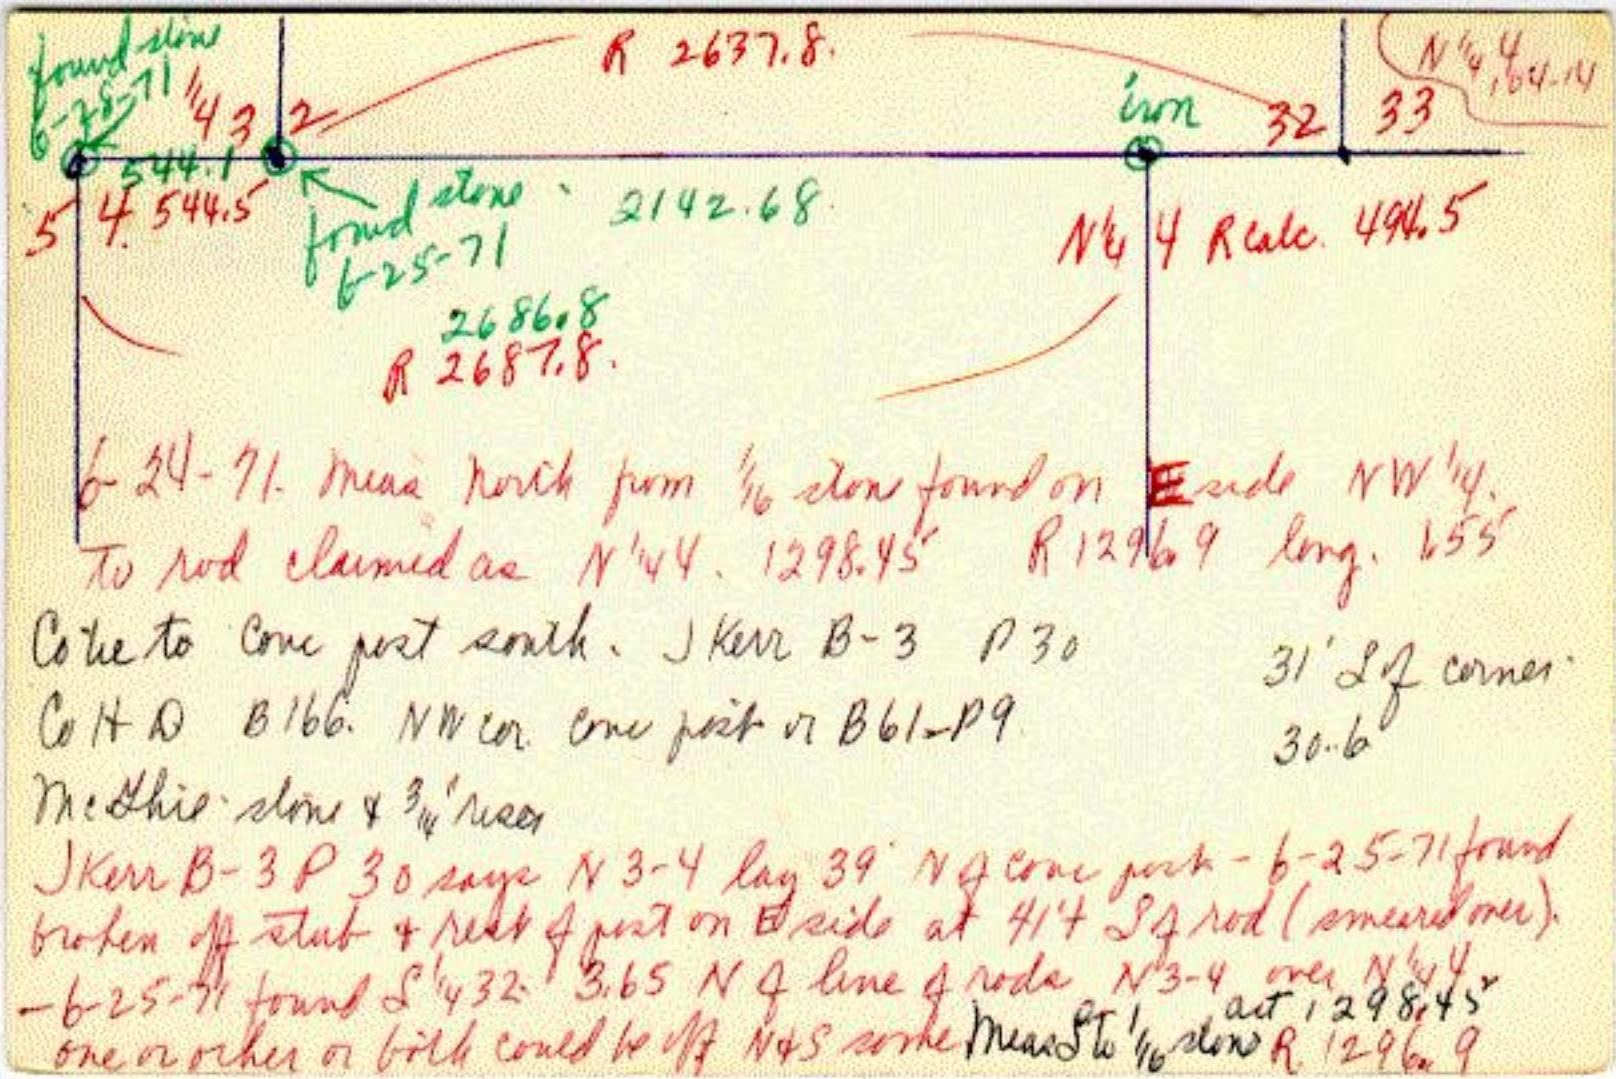

6-24-71. Meas North from 1/16 stone found on E side NW 1/4.
To rod claimed as N 1/4 4. 1298.45' R 1296.9 long. 655'

Co to Cone post south. J Kerr B-3 P 30

Co H D B166. NW cor. Cone post or B61-P9

31' S of corner
30.6

McGhie stone & 3/4' west

J Kerr B-3 P 30 says N 3-4 lay 39' N of cone post - 6-25-71 found broken off stub + rest of post on E side at 4.7 S of rod (smeared over).
- 6-25-71 found S 1/4 32. 3.65 N of line & rods N 3-4 over N 1/4 4 at 1298.45'
one or other or both coned to W of N45 corner Meas S to 1/16 stone R 1296.9

#440408 (3)

1/4 corner North 1/4 4 104-14 High Forest

7-27-74

Dug with backhoe - Found hub rod + 1 stone 3' deep. in the ℄ C.R. #6. Accepted corner - drove a 3/4" x 3' rod on the South side of the stone - Set a C.I. m over the stone

R.P.'s

Co. S. disc on N.W side of P.P. w/ Transformer N.E. 119.22'

20 d. w side 10" burr OAK S.S.E. 64.1'

N.W. cor. Conc. cor. post (No fe. going South) South 33.03