SET CIM 8-10-95

#440504

1/4 Cor 5-8 Hi Forest 104-14

Gout Notes: Ball, 1853

West on true line Between Secs 5 & 8

Set quarter Sec Post @ 40 chs.

Br. Oak 8" S 33 3/4° E 100 lks


Br Oak 12" N 22 1/4 W 48 links

5-17-95 FD ~~IRE~~ IRON W/CAP # 22663 13" DEEP IN & E-W TWP RD ON COUNTY LINE. IT LINES WITH FENCE ± 500' NORTH PROPERTY COR (5/8" REROD) NORTH 33'

6-13-95 DUG WITH BACKHOE TO COVER IRON W/CAP + M+L LOCATIONS. THE CLAY LINE AVERAGED 3½' DEEP. WE FOUND A DIGGING SPOT THRU LOWEST ROAD AND DEEP INTO CLAY (3' ~~CENTERED~~ SQUARE IN SHAPE CENTERED ON THE CENTER OF THE ROAD

OVER →

6-13-95 CON'T. — AND FROM THE IRON LOCATION WEST THE 3'). WE DUG FROM 3' EAST TO 7' WEST OF IRON FD + FROM 3' NORTH TO 7' SOUTH OF THE IRON.

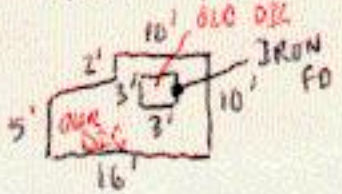

8-10-95 UPON DIGGING + MEASURING NORTH + SOUTH IN SEC 5+8 WE DETERMINED TO SET THE 1/4 COR AT THE IRON WITH CAP POSITION WHICH MATCHES 1/4 LINE FENCES N + SOUTH + THE PARCEL SPLIT PROPERTY CORNERS TO THE NE. SET CIM OVER 1/2" IRON IN ℄ E-W TWP RD 19 1/2' EAST OF ℄ FIELD DRIVE SOUTH.