#440506

X 10-20-72 set C/M by records from existing corner stones (1)

1/4 corner 5-6 Ht Forest 104-14

6-1878 Hunter P348 No 341 26 C L Goodrich & others.

Corner gone all B trees gone. Mr N Lyon and son who prompted the SW 1/4 5 owner they were present when Correction survey was made and saw corner untill recently and also N E Cor 6. and that their north and west fences were exactly by measurement 2 rods from said stake so set boulder 10 x 15 x 30 from these fence lines.

5-1940 Co Hwy Dept.
3/4" rod over stone Mon
Elec tele pole. S.W. 50.95
" Cor F post E 33.45
P I Δ 0° 37½ Rt going E.

5-27-1950 J Carr.
B46 Page 72.
used E 1/4 & W 1/4 Sec 5 to lay out property with angles south on fence. total mile 5302.8 set prop corners corners likely County Rec.

1960 Du Val Minn Hwy Dept.
found stone 2½ x 5 x 7 8" deep at ℄ N-S-W roads & fence line E.
Dirc tile pole NE 41.2.
" " ℄E 42.3.
" power pole NW 46.6.
No Good over 4' fill

1964 Co Hwy Dept ¾" rod. B290. Maybe ½" rod. 1969.
Dirc in tree NE 84.40. (Pointed LS with stake
" tile pole ~~NW 50.62~~ WNW 6 6.9 beside road 1940 stake
" power pole ℄E 42.67. Hub near FP SW 68.3
" tile pole NNW 101.3
" Co fence post NE 46.55
No Good

#44050 (2)

Card # 2. 1/4 5-6 Hi 7 for 104-14

B 109 P9 Co. H.D. 1940.

3/4" iron over stone used ties B62.
used stake found by stone as true corner

- Meas west to center 6 2603.7 . No Good
- meas east full mile 5302.4
- Meas west full mile. 2603.7 + 2572.1 - 5175.8

Co H D B 290 1964. found 3/4" rod over boulder

None of the above corners are the true location of 1/4 5-6 which is some 35' west - these corners which differ some are really extension of High Forest streets. More or less and rod are center line of county road Nothing more.

over

Chas Armstrong in 1900 ~~west~~ this corner with large boulder but not as large as J Hunter in 1878 as Hunter had no mear to center and Armstrong did have mear from stone (found 12-1971) at S-5-6 and did set stone north as corner of 100 acres with midway stone west of record mear (stone found 1972) and Hunters stone on line from center 6 and 1/16 stone west (both found 1971) it is only way out to meet 1/4 5-6 at inters of line from west and line from S 5-6 over point (now in North ditch of Hwy 90 the same east of 50 acre stone as west, 1313.85, Hunter stone 10x15x30 armstrong 12x12x16
It is possible E-W location of 2 stones aren't anywhere near and also possible Armstrong stone not on prop line from Center 6, west. Re setting corner on inters of these lines only way out Neither stones could be in place or both maybe

see card 3

Card # 3 1/4 5-6 High Forest 104-14. #440506 (3)

On 11-4-71 dug with Keller air hammer at point used by Minn Hwy D and Co Hwy D. in line road north & south. -found tube but no recorded stones. abandoned pit for 1971.

— 10-25-72 set random nail on exact line from 1/16 corner west of Center 6 over center 6 for use to traverse N line 6.
- measr nail from center 6 and computed from it north.
- dug with County air hammer near 6' deep covering any possible place stone should be, stony clay mixed full at all depths- typical of every corner dug in this area
- set C/M over 5/8 x 12" iron on line from west and 2573.77' east of center 6 * 2661.09' north of 25-6 C/M

over.


correction NOTE N from ¼ cor E-6

South 2548.08 (2548.48) ℄ iron set at N 5-6
south 1665.14 to point when set at ℄ E corner 100 A.
then 995.95 to ℄ S 5-6. C/M.

C.H.D.- 1925 Book # 38 Page 89 shows stone

NW Cor Public Square, High Forest Village

11/2/78 Set up a point 396' North of the nail set in the intersection of Colvill and Main St. in July 78'. Then began digging @ a point 40' East and 33' South and dug

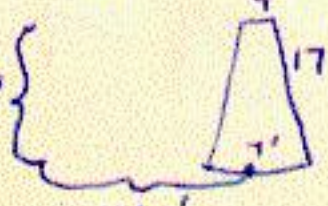

The area had been subcut in road construction. Found nothing -

HI FOREST ¼ CORNER 5-6 #440506 #4

Gov't Notes Ball 1853
North between sections 5 & 6.
40.00 set ¼section post.
Bur Oak 10in. N-65 E-91 lks.
Bur Oak 7in. S-70 W-97 lks.

7-5-96 - FOUND CIM IN GOOD CONDITION 2" BELOW SURFACE OF CR #6
REFERENCING FOR ROAD OVERLAY.

RP's
CSD IN E SIDE TELE BOX POST NW 31.66
PUNCH MARK IN TOP PIPE C.P. NE 88.53
CSD IN PP #45427 SE 66.20