1 10-25-72 set 5/8" x 3' reinf rod by line west and recorded Measure. (T.H. from West) #440507 (1)

Section corner North 5-6 Ht 7 over 104-14
6-1878 Hunter P 348 No 341 S6 C L Goodrich & others
Corner in dispute which was resurveyed by Govt Deputy Surveyor.
this was witnessed by Mr N Lynn who was present when stake
was set and new B tree taken. Found stake in mound
with unmarked stake by it which checked very close
to stamp of S E B tree with marks plain
Govt witness S 25° E 133 lks actual S 35° E 130 lks.
Mr Lynn owns corner to be the same as set.
-Meas east to S'ly 31 ~~to N'ly etc.~~ (668.58
maybe - 9.13 (602.58

(over)

1-1938 J Kerr B 12 P16. MrsWE Lamp B18 Hi Forest.
No Good — Pulp
found. NE cor 26 - hole in clay where stake had been pulled.
drove iron stake in hole. set wood stake by deside & piled rock
around it - this corner. 421.6 west of S¼ 31.
this corn 3/4" x 21" drift pin driven deep. Tied to fence line N.
Nail — NE to pin oak 29.5 Nail — S of E to burr oak stump 61.5 (no meas.

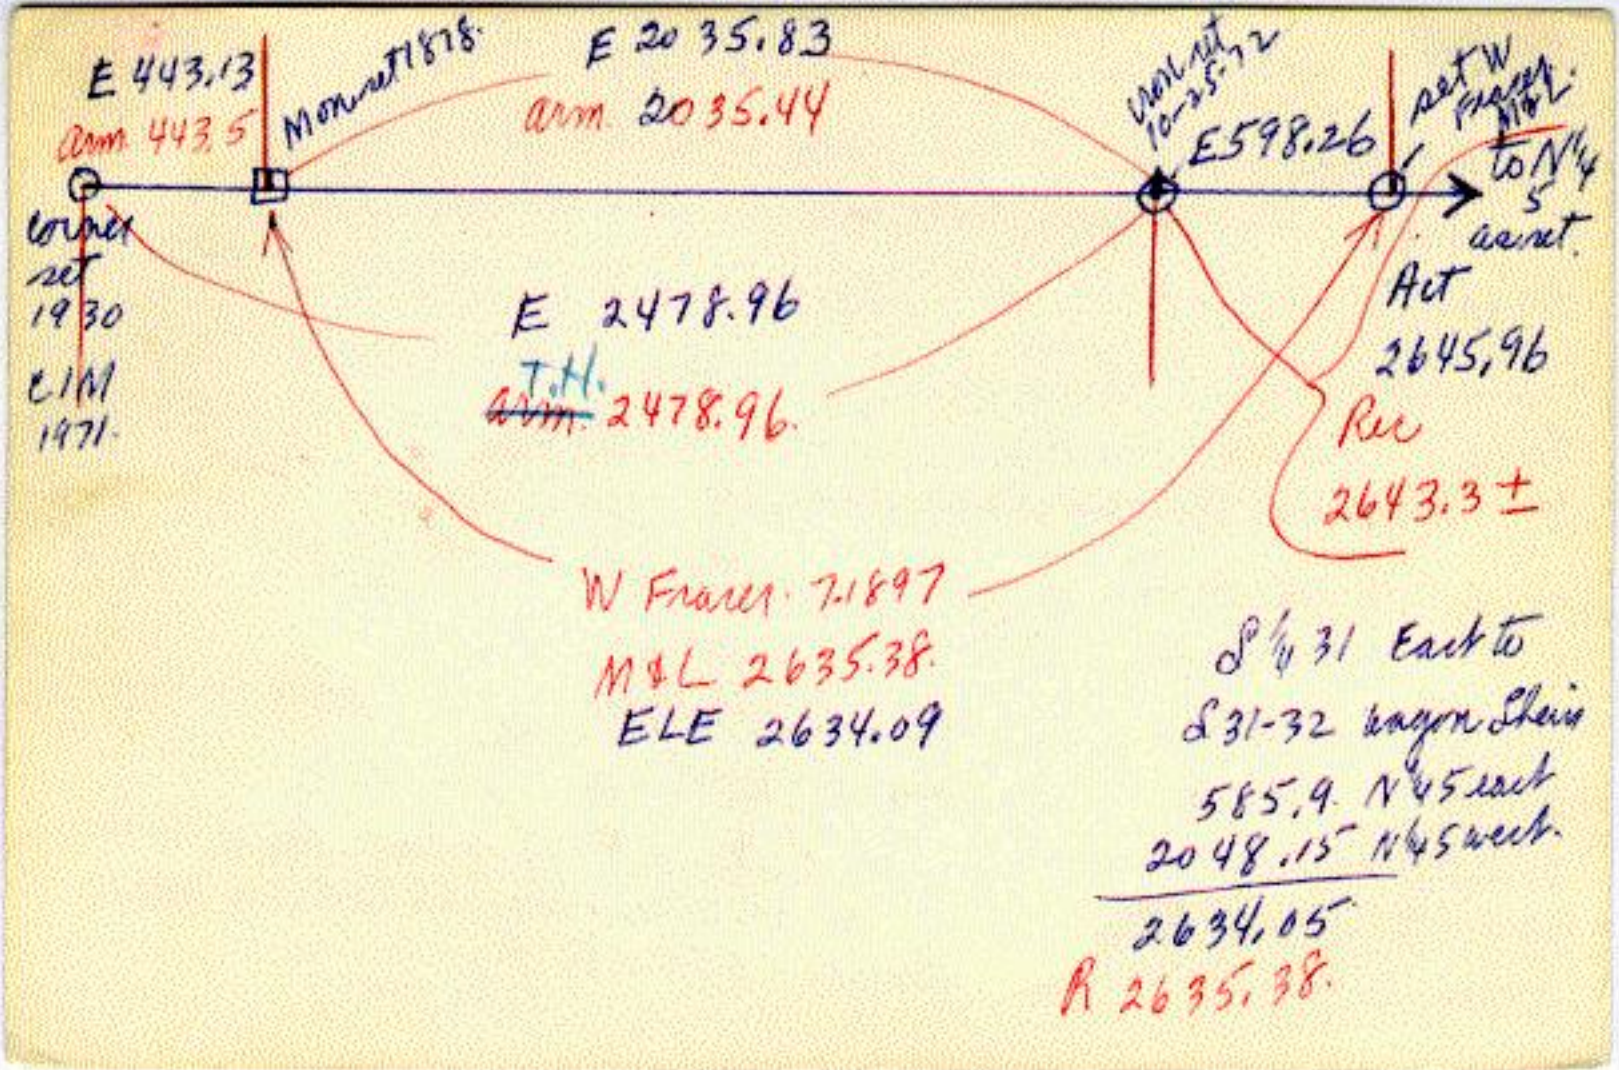
6-1-1971 Co Surv. found true S¼ 31 set by J Frame
1897 and found by J Kerr 9-1939. set C/M over same.
- found 1" pipe set 9-1939 257' east and 20' south (true section
line east came 17.22 north of 20' pipe -
punched line from 20' north of pipe over ¼ corner & found above 3/4" x 21"
drift pin down 4'+ at 421.5± about .15 south this line.
- RP. 10' north of road running west some 18" north of ridge road -
49.55 S E to center corn Wind one calc - 66.2 S W center of old pole up 4 feet
total distance Meas from S¼ 31 W to Lupton 2633.53

2 North section corner 5-6 High Forest 104-14 (2)

10-25-72. set 5/8" x 3' reinf rod as final corner.
on range line (computed) between S 1/4 31 and S N 31.
High Forest 105-14 at 598.26 west of S 1/4 31 #440507
- total final on 2nd traverse, this line elec meas -
6-1977 meas by hand meas traverse 2633.53
10-72 Meas traverse elect 2634.09

rod comes in center of bottom of north road ditch which
is 2'± below field, 14'± below road grade.
40.55 W N W to bottle cap S side PP 6810 bullet hole.
21.0 S to center road running westerly.
598.26 as result of Armstrong record of N line Sec 6 & Sec. 5
S 1/4 31 to N 1/4 6 actual 30 Th. 22 - armstrongs 2478.96 a meas
from N 5-6 to N 1/4 6. leaves 598.26.

(See over)


E 443.13
Corr 443.5
Monument 1878
E 2035.83
Corr 2035.44
Found nail 10-25-72
E 598.26
Set W Frame Nail
to N¼ S corner
Corner set 1930
E M 1971
E 2478.96
T.H.
~~Corr~~ 2478.96
Act 2645.96
Rec 2643.3 ±
W Frame 7.1897
M & L 2635.38
ELE 2634.09
S ¼ 31 East to
S 31-32 Wagon Shein
585.9 N 45 each
2048.15 N 45 each
2634.05
R 2635.38

HI FOREST NORTH 5-6 #3
Gov't Notes Ball 1853 #440507
North between sections 5 and 6.
78.07 Intersected north boundary line 440 lks. west of ¼ section post to south section 31. Set post.
Bur Oak 12in. S-25 E-133 lks.
Bur Oak 8in. S-53 W-231 lks.

---

c-1878 T.H. BK 'A' p. 348-349 Sec. 6 C.L Goodrich & others
at 'A' NE Cor. Sec. 6 – (direct quote) "this Corner has been in dispute for years between the Settlers and Surveys have been made from different points but mostly from a point where stake stands about 20 rods east of the True Corner, as established above from the S.E. Witness Tree and other evidence conclusive To my mind, the evidance being as follows we found a stake not marked standing by the side of the remains of an old stake in the center of a mound with Two of the pits visible, and we also found the S.E. Witness Tree cut and lying on the ground by its stump and on examination found on cutting away the growth the original marks – T104N R14W S. 5 all plain, the bearing and distance from the mound and stake To the stump of said Witness Tree was S35°E 130 lks., the U.S. field notes calling it S25°E 133 lks. which is as near (ever)

or nearer then the majority of the field notes for witness Trees will average especially in the South and S.E. part of the County.' And further Mr. N. Lyon who lives, lives on, and preempted the S.W.¼ of Sec. 5 avers that he was present and saw the Dept. Surveyor when he made the corrections and that he was with the Surveyor when he set this Corner at 'A' and that he has often times since seen it, and that the stake found with witness Tree is where it was set in record. The S.W. witness Tree has been cut and grubbed out.

(Special Note) at heading of above survey - BK A p.348
Soon after the Gov't Surveys were made, complaint was made to the Surveyor general that the Surveys along the Correction line, the Closing Corners were inaccurate and the Surveyor Gen. Sent a Dept. Surv. To Correct Said Surveys in T 104 R 14 which he did simply moving the Closing Corners on the Std par. and the E & W ¼ posts of the Closing Sections in said T 104 N R 14 W - a certain distance West this Throwing the NE Cor Sec. 6 west considerably.

"440507" G

11-2-98 North Section Cor 5 & 6 T104N- R14W

High Forest Twp

Fnd 5/8" Rod Flush in N. Ditch

Fnd leaning East

Checked tie to P.P. # 6810 WNW 40.84'