
1 6-29-71 set CM over stone Left by J Kerr. 12-1930.
#440608 ①

¼ corner north ¼ 6 Ht Forest 104-14.
See field BK 5 p. 73-75
6-1878 Hunter P348 No 341 & 6. C L Goodrich + others.
no corners set in orig survey, set stake
Meas line carefully. 75.22 chs Govt record 80.10
Fd BK 5 p. 74 B.T.s To N.¼ 6 J.O.6"-S10°E 71 lks J.O.6"-S75½°W 64 lks
set stake on line ¼E 36 (Twsp cor) and ¼ 36.
Meas west - 37.66 Meas east 37.56
-16 west set stake on line and 18.78 then 18.88 to NW 6.
-16 ~~south~~ west 40.10 : 3766 :: 20 : 18.78.
-16 south. corner in back-water slough - set stake 4 rods south.
Meas Govt meas 38.15 : Act meas 38.48 :: 20 : 20.17.
Making meas south 18.31 chs 20.17 to corner = Center 6

18.78 9.39 9.39 .672 Twsp cor

Twsp cor

see other side survey. Ch Larson 1911

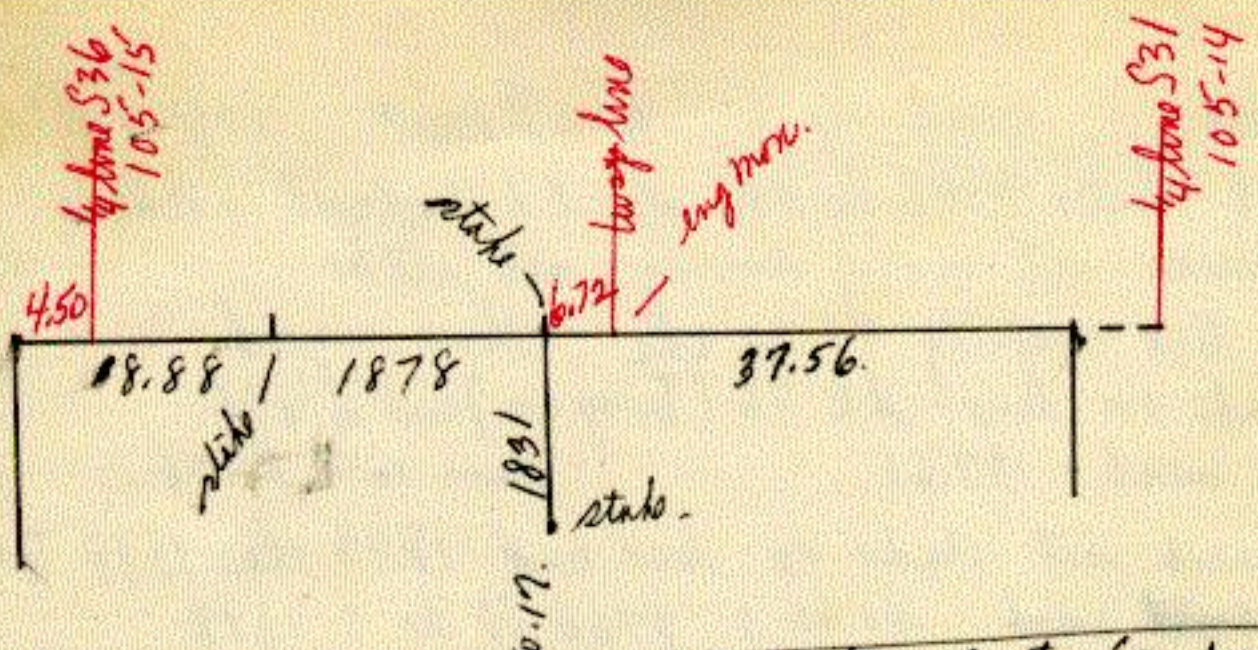

4-1911 Ch Larson P156 B. L6 Eador Peata (can't read).
set stake at N'ly 6 as plat reverse side card. No explanation

12-23-1930 J Karr B4 P63 Goldberg - Leaman survey.
set N'ly 6 at 443.5' $\frac{30}{2}$ west of standard corner (twp cor)
on straight line set stone 3" thick x 17" long run to flat point
on top. with stake on North side - Run & meas south plat.

#440608 (2)

Card # 2. N 1/4 6 High Forest 104-14

6-8-71 Co surv. Meas from SW 31 105-14 found ingraved Township corner, west recorded 443.5' set nail

6-22-71 dug with tractor found stone set by J Kerr 12-1930. 443.05 west of Twsp corner.

- corner lies .22' north of direct line from SW 31 105-14 and S 1/4 36 105-15.
- for 1/16 iron west a 105-15 corner see S 1/4 36 105-15.
- set iron on N side of L stone hardly 2' deep
- 63.25 WNW to hard nail by PP grd wire # 6018
- 93.4 NNE to hard nail on E side cedar tree in yard.
- 45.1 NW to single punch in east edge center E end 12" drive culv.
- corner lies 2' S center traveled road.

10-26-84 Dug @IM. It appears leaning SE and tie to pole WNW .15' long. Did not have time to dig down to shot as found.

11-2-98
TD-Jamie Idrow
Bob Bradley

N1/4 Sec 6 T11N-R14W "440608" E
Fnd CIM down 0.4', leaning in
the southerly direction
leaning 0.11' East & 0.07' South
Dug out & re set CIM over Stone
Took tie to nail in P.P. # 6018 WNW 63.46'
Property Pin South 33.00'
SE Cor Trailer House NE 93.90'