
#450307 (1)

section corner. North 3 - 4. Hi Forest 10 4-15.
6-1877 Hunter P319 No 313. S 3 J Brewer, J Saulsbery. J Ruckett.
B trees gone & grubbed. - found stone in past Pole
covered by. Mr Gordy to be where orig cor stood
corner in line old fence south.
- Meas east to corner set M & L. 40.02.
- Meas south to stake found & boulder 6x8x16 set 39.06.

6-1878 Hunter P 351 No 343 S 4. John H Smott
found stone as corner P319.
-16 West set stake M & L. 20.06 1/2. to N 1/4 4 set M & L.

7-1893 H Fraser P 521 No 487 S 33 10 5-15 C. Roeder.
found stone P 351. stake by side.

-16 west planted boulder stone N & L.
this survey a road layout merging from west sec line 33 105-45. to 1/16 line west of NW cor 3 then south on that 1/16 line. 1/16 boulder lies where road turns south on range line. Road cut-off starts 25 chains south of 1/4 cor 32-33 then S 20 3/4° E 15.97 chs to range line then east to 1/16 boulder then south on 1/16 line. which is 9.31 1/2 or 6.00 back to SW cor 33 a stone 6x6x18 set in place state this survey

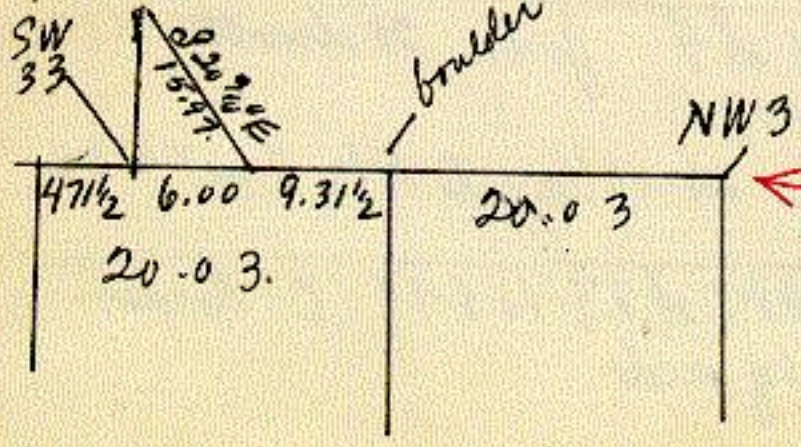

1935 Co Hwy Dept finds limestone North side cor post B 99.

Card #2 N 3-4 104-15 (2)

1935 Co HD B75 P78. bk 79 #450307

found L stone 2 x 4 x 18 on N side corner post 6"

Meas 2641.2 west Fd stake on E-W fence line.

searched for 1/16 corner between

1/16 West of N 3-4

11-15-93 Fd Boulder Stone set by W.F. 8" x 12" x 18"

Dug with backhoe. Fd stake on east side of stone about 12" of stake was remaining it seemed to be leaning. It was .50 East of center of stone. The stone was .4' deep in grassy area where old road ran @ one time (Left stone as is) with ✱ Iron on East side & short 3/4" road on west. It falls in line of brush row East.

Gov't Notes on back →

Gov't Notes Ball 1853
79.04 Intersected 1st. Standard Parallel line 535 west of ¼ section post on south boundary ## of section 33 Townshipp 105 North of Range 15 west of 5th. Meridian.
Bur Oak 20in. S-85 W-204 lks.
Bur Oak 18in. S-81 E-216 lks.

11-19-93 We had probed & dug around C.P. @ an earlier time in this survey but decided to look for other corners first. After finding the 1/16 th west ¼ Sec Cor west also N¼ of 4 104-15 for distance. We dug at line & double dist. which comes 1½' NW of 12"x10" Square concrete C.P. to fence E-W-S. There is concrete base out 2' around the post this has destroyed any sign of Corner. We dug in clay but all was disturbed @ Corner location.