1 10-26-83 Set CIM.

#511005 (1)

section corner. 9-10-15-16 Elmira 105-11.

4-1878 Hunter P339 no 333 & 15 H. Gardner etal.

found remains old stake from both BT. standing

set stone exactly in place of stake. Old stake in center

small pile of stones

Meas east to 1/4 stone 40.02. placed this survey

in place of old stake. - Stone found & 9 P340 no 334 no meas

4-1892 Thos Fraser P477 no 456 & 10-11 Wm Ferrier

found stone set by Hunter P339 & P340

Gov't Notes

Set sec cor post 80 chs.

10" Burr Oak N 30° E 58 lks (38.3)

10" Burr Oak S. 51° E 172 lks (113.5)

10-26-83, Sec. Cor. 9-10-15-16: Found a 3" x 7"/10" x 24" limestone (up 10") chiseled down into rocky sidehill and packed in limestone pieces. Also found a 24" Burr Oak S50°E 113.6 with old blaze rotting through (Bwit B.T. S51°E 172 lks = 113.5). There is also a 21" Burr Oak appx. N50°E 39.0 (Gov't B.T. N30°E 58 lks = 38.3) which may also be the NE Gov't B.T. since Hunter said the bearings to the B.T.'s were not good. The NE tree is now being used as the corner post to fence running N-S-NW-SE. Drive a 1/2" x 10" re-rod down into bedrock at stone location and set a

#511005

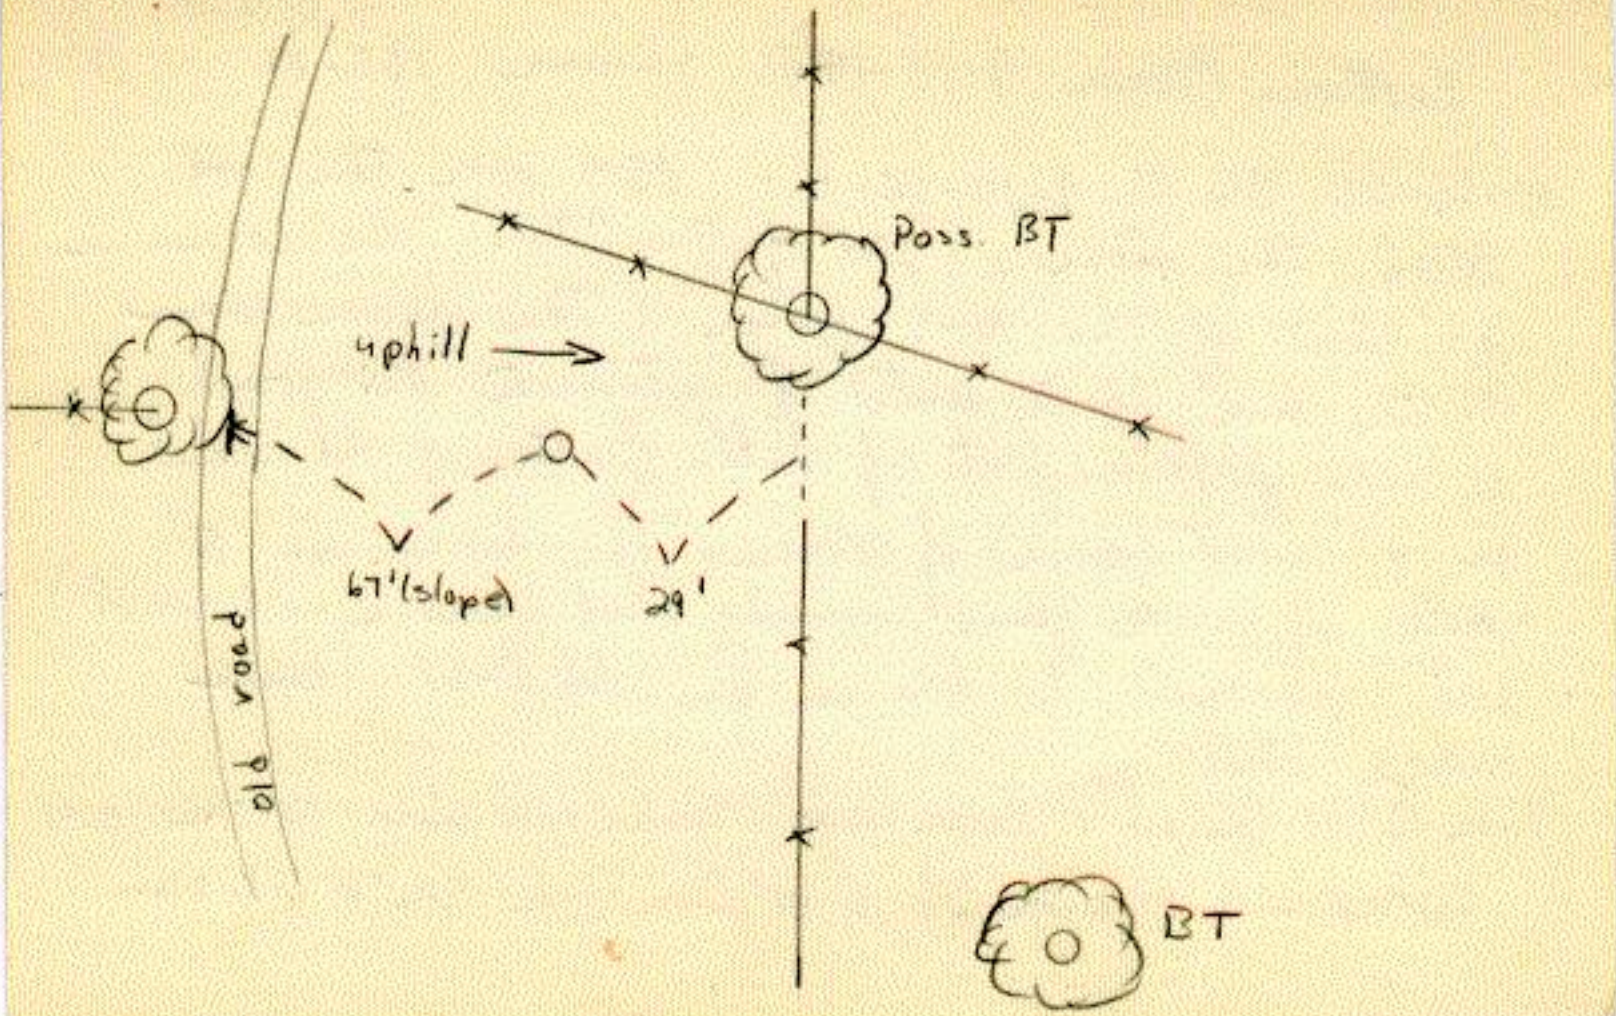
(2)

Section Corner 9-10-15-16, Elmira, 105-11

10-26-83, Sec. Cr. 9-10-15-16: CIM over the rod. Stood the stone .8 SW of the CIM. The corner is 29' West of the N-S fence (This fence runs North and South until it intersects old road which follows foot of hill. Center of old road is 67' West (slope) of corner. The corner is 5' South of newer fence running West (across old road) but appears to be in an old E-W Fence ridge itself.

Took RP's: Blazed 7" Burr Oak - Spike NW side S33°W 10.41

Spike & CSD W. side blazed 10" Burr Oak S22°E 38.32


Poss. BT
uphill
67' (sloped)
29'
old road
BT