10-25-83 CJC/p²

#511506 (1)


1/4 Corner 15-16 Elmira 105-11.

4-23-1878 Hunter P 339- no 333 $15 H^n Gardner
T.N. OKS P 58
found stone planted in center road. claimed by Gardner as set by surveyor as placed when stake was in mound.
line east no mete N 89°35'E.

Gov't notes: set gr. stake & stone 28"x4"x6" mound + pits

10-25-83, 1/4 Cor. 15-16: Dug for stone found by Hunter in the center of the old road! Old road surface can't be distinguished here but road extended from the South over old bridge falls near short piece of N-S fence, so dug with backhoe in line with fence West and on East and West side of short fence. Dug 4' North and

4' South of the fence West and 4'± East and West of the shut N-S Fence.
It was 4' deep to clay and marly fill but found a 3"x8"x12" limestone dug in and standing perfectly. The top of the stone was 3' deep and right at the level of the remaining natural ground. Some of the stone could have been broken off. Found mark beneath stone that could be the stake mark but no wood remaining. Moved stone .55' West to make room for CIC/P² monument and set piece of cast iron around it. Drove a long tiltpar with a Cast Iron Cap on the corner

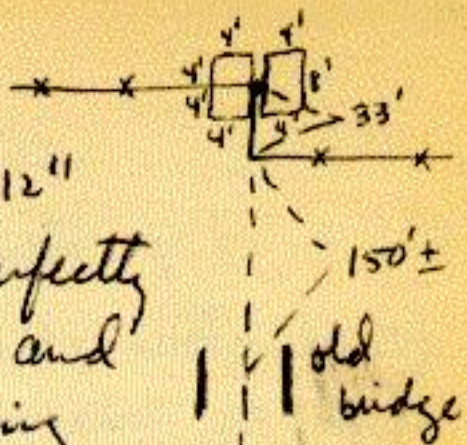

#511506 (2)

1/4 Cor 15-16, Elmira, 105-11

10-25-83, 1/4 Cor. 15-16: (cont) Corner in line with fence West and 1.3 East of the corner post to the fence West and short fence South. Nailed survey marker sign on C.P.

RP's: C.S. Disc in North side corner post W 1.26
C.S. Disc in E side brace post SSW 7.14
C.S Disc in N. side gate post W 19.94