j 6-19-73 found L stone, set pointed L stone over stone & stake.

#511905

section corner west 19-30 Elmira 105-11

east 24-25 Orion 105-12.

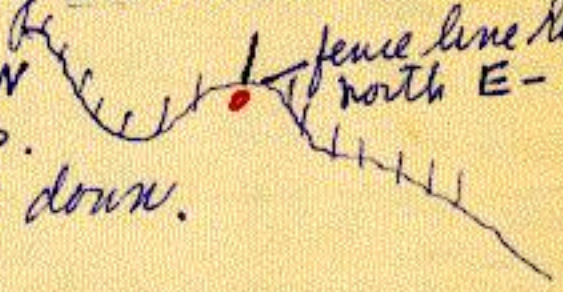
4-1875 Hunter P336 no 330 L 24-25 T Moore etal.
found old stake in ground a point indicated by N W & S W
B trees set new stake.
1/16 west set stake 19.91 9/16 M & L. 1314.39. N 89°55'E
1/16 south set stake. 19.97 1/2 M & L 1318.35
1/16 center NE 1/4 25 stake 20.03 3/16 M & L. N-S 1/16 line.
(1322.48)

11-1894 W Fraser P 559 no 514 L 30 E. Lambert & M'Cully
corner fence post anered by Mr A M'Cully as placed in place
of original stake by himself tested on remaining B tree.
1/16 south. found stake placed by Hunter 19.98 M & L.
1318.68

over

1/16 east drove iron & wood stake at line and meas
19.73 chen 19.98 To N 1/4 20 stake & 2 stones.

1302.2. 1318.7

6-19-73 ran part of extensive survey. to corner area.
found. limestone 3x7x12 in good vertical position
just south of corner post. very unusual and lucky as
location in vertual island. 

lands south slopes sharply up.
lands north and east sharply down.
no RPS. meas S.—
meas W.—

Gov't notes: Sept. 1853 — Set Post for Corner
B.T.s Burr oak 10" S 62°W 42 links
aspen 10" N 4°W 105 " Burr oak 10" N 17°E 103 links