/ 9/1/89 SET C.1.C./P²

#512204 (1)

1/4 corner 22-27 Elmira 105-11

6-1872 Hunter P 208 no 216 & 27 John Kuefe found small stake by side fence post which mr cole avers he set in center mound 16 years before. pits still quite plain.

1/16 east set stake M & L 19.95 1/2 (1317.0 N 89°55' W

6-1873 Hunter P 230 no 233 & 22-23 Fry-O'Farry-Jennings found short stake by fence post P 208.


1/16 east set stake M & L no meas.

1/16 north set stake M & L 20.13 1/2 1328.9

over

Govt notes: set gr. Post & Stone 18"x14"x2"
Mound & pits

7-10-85: ¼ Cor. 22-27 – Dug at fence corner to fence West and North with backhoe as follows:
Fd post hde with limestone pieces packed around on the South side of the present c.p. Post appx 5" to 6" diam.

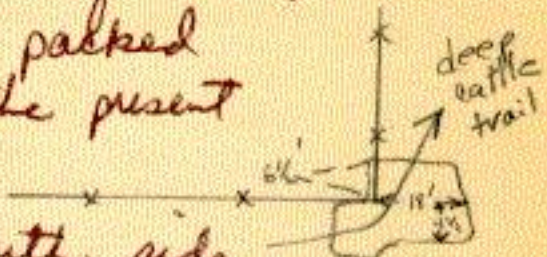

Also found a post stub on the south side of the present ~~corner~~ brace post north of the corner post. There was some more wood piece on the SE side of the stub. Could this be Hunter's post and small stake? Dug south and found no more posts so fence apparently did not run South. Dug east since we measure 1331½ to the fence corner at the ¼ E and Hunter had 1317.03. Found nothing further. Fence apparently didn't run East either. Deep cattle trail as indicated. Post stub by Brace } N 1.50 SW 7.96 Pass Stake } N 1.83 SW 8.08 t.n } N 7.47 WNW 6.60 Post Mark by C.P. } N 7.42 W 7.10

1/4 CORNER 22-27 ELMIRA 105-11 (2)
9/1/89 SET UP T.N. FROM 1985 ALSO #512204
POST MARK FD 1985 TO CHECK POSITION
OF 1/4 COR. TO BE SET. SET 4' LONG
TELSPAR PIPE | C.I.C. FROM N-S 1/4 LINE
IN SEC 27 USING T. HUNTER STONE MARK
FD IN 1985 OVER T. HUNTER STAKE AT
CEN. 27 FD IN 1985 WHICH COMES 0.94'
EAST OF T.N. AND 0.44' EAST OF POST MARK.
USED POST MARK FOR NORTHING & LINE FROM
SOUTH FOR E-W POSITION RP'S
C.S.D. IN BRACE POST WEST 7.22'
C.S.D. IN BRACE POST NORTH 7.48'
FACE OF C.P. TO FE. W½N N.W. 1.1'
THE CORNER FALLS IN LINE OF MAIN LINE OF
FENCE W-N, E-W FENCE So. 30'