#512709

1

1/4 corner. Center 27 Elmira 105-11.

6-1872 Hunter P208 no 216 & 27. John Keefe.

set stake at true inters lines.

1/16 north set stake N 0 L 19.93 on N-S 1/4 line N 40' E

1/16 east set stake N 0 L 19.95 on E-W 1/4 line S 89 3/4° E

Meas west 40.19 (2652.54. To 1/4 cor. stake 11

1/16 center NE 1/4 27. set N 0 L 19.91 (1313.06 on N-S 1/16 line

1314.02


N 1/2° E

Corner in level bottom land.

corner 3 farms. common land North of 1/4 line.

7-19-85, 1/16 North: Dug from a point 4' West of the t.n. (under east-west fence - See Drwg 25-105-11-6) for 10'+ West, 3' North, and 2½' South by 2'+ deep to clay. Found nothing.

7-19-85 Center 27: Dug as follows from the t.n (set 1' South of I-beam C.P. See Drwg 25-105-11-6):

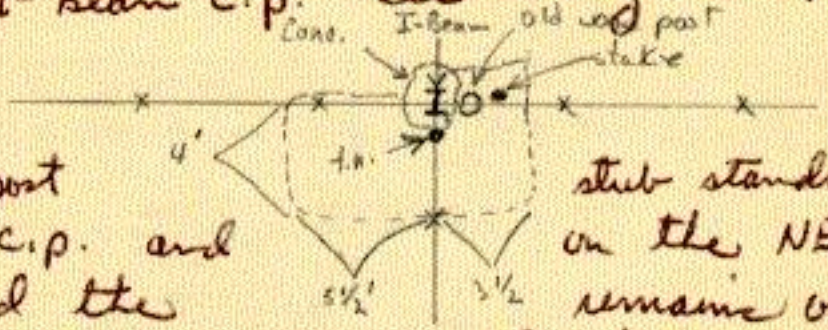

Found an old post stub standing 1.4 east of the I-beam C.P. and on the NE side of this we found the remains of a stake approx 4" diameter with wood piece at the clay line (down 2½"). The stake hole tapered to a point about 6" into clay. The stake is approx 2.9 E and 1.95 N of the t.n. Drove a 2"x2" hub at the stake location. Hub just on the N. side of the E-W fence } LRP stake } 1.79 E 5.90 S