12-6-1968 set C/M over orig stone – glass, bottom steel F post.
section corner. west 30-31 Elmira 105-11. (1)
east 25-36 Orion 105-12
4-1878 Hunter P336 No 330 S24-25 J Greenlee.
found orig stake, well down at fence cor. T moore.
1/16 north set stake M & L. 19.98.

#513005

5-1901 H Fraser P12B S31 M Fowler.
used corner fence post
Meas 39.77 east to 1/4 corner which is
not midway but on line 39.77 then 40.09 3/4.

11-1968 run line from SW 31 Twsp cor, at 10' (2) east
set W 1/4 31 in place old post also 1/16 cor south.
record meas SW 31 north 19.91 (1314.06) first half 1313.55 each
push line north 2627.1 1/2 orig extensively finally found (over)

old barb wire running east and west 2½' deep dug on
-this wire west beyond fence running north some 400 away
on digging east found wire loops running E-W & N deeper
found stone and wire running south set C/M over (glass) wire
& stone 4" below sod with stub post below broken off just
above spade. corner came. 1.52' east of random ⑤ line and
1.3' north 2627.1 which made north half 2628.4 and
south half 2627.1 making ¼ corner .76' west of direct
line.
— set 2½" galv pipe up 2' north of mon .7'
— corner lies about 6.0 east of fence running north undistance
of some 400' north. no fences to corner above ground
corner lies in open pasture in crook of mill creek.
— 36" lone willow tree 15' south of east (center of Tree) 91.5


Gov't Notes: Sept. 1853 - set Post, built mound & drove ch. stake.

#513005 (2)

Section Corner West 30-31 Elmira 105-11

East 25-36 Orion 105-12

RP's furnished by Mn/Dot:

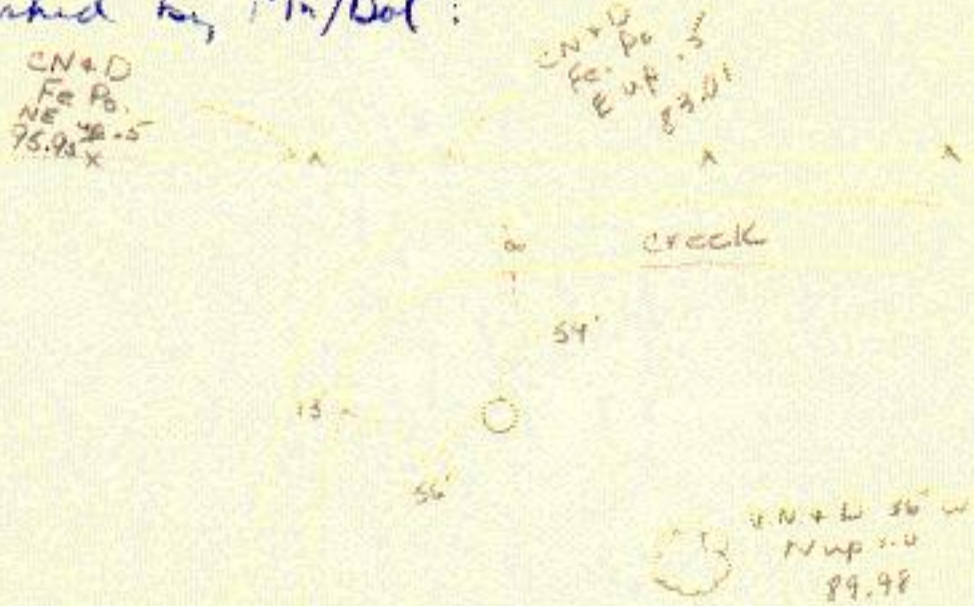

4-11-91 Co Survey Crew set Post & Sign
1' west of C I M