8-1-85 CJH

#513404 (1)

S. 1/4 cor Sec 34 105-11 Elmira Twp

No Records can be found in Olmsted County on corner location other than the Gov't Notes.

Sept. 1975


found the S.E. cor sec 34 and reset the S.W. cor. of 34. We set an iron rod in the road to maintain our work done at this time. the iron is .16 West & .12' North of a m+L pt. Must dig for corner

Gov't Notes.

Set 1/4 sec. post, built mound, drove charred stake, dug trench, and planted apple seed.

7-31-85, S 1/4 Cor 34: Dug from ½" rebar found in E-W road and in line with fence West, for 7½ West, 5' North, 4'+ South by 5' deep to clay. Td mark of dug in post 5.4 West and 1.8 South of ½" rod location. ~~Found~~ Found good stake hole 7.52 W. and 2.07 South (eyeball) of the ½" rod location. Drove ½" x 6" rod in the stake hole

8-1-85, S 1/4 Cor 34: Continued digging to 6' East of the ½" rod (removed) by 6' South and 3'+ North. Td nothing further. Then dug over 3/4" rod set appx M&L in 9-1975. Td nothing there either.

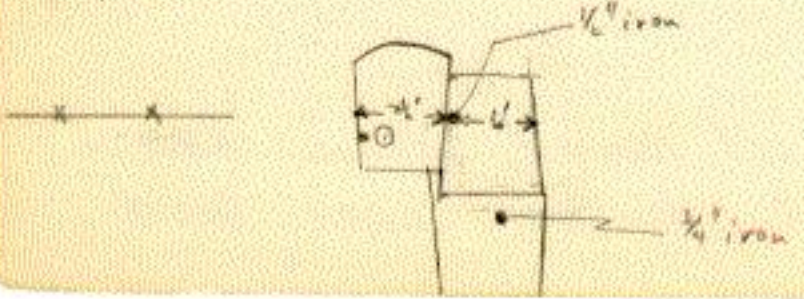

½" rod NW 12.85
SW 12.85

stake N 12.86
NE 17.13

S 1/4 Cor 34 Elmira Twp 105-11 #513404 (2)

8-1-85, S 1/4 Cor 34 cont.: Accepted stake hole as corner. Set a CIM over a 5/8" rerod at the road surface. Corner 7½' West of road center line and 2' South of fence running West.

Note: post hole found was 32' east of old road fence on the west side of the road.