8/29/85 Set C.C./P²

#513406 (1)

¼ corner 33-34 Elmira 105-11

Gov't Notes

Set ¼ sec. post M+L 90 chs 196

10" White Oak N 46° E 198 lks. 129.36 ~~130.68~~

14" Black Oak N 32° E 184 lks. 121.44

T. Hunter Book 5 p. 60 Sec. 33 for E. Tuohy 4-1878

at "H" E.¼ 33 - found orig. ¼ post standing [redacted] also the wit Trees Tested it & found Correct.


Meas. South 19.98½ Then 19.98½ To SE 33

Meas. North 19.92½ Then 19.92½ To NE 33

West 19.77½ Then 19.77½ - Could be 19.92½ x 19.92½

"15" - 1/16 west set stone 21 x 8 x 3

7-1-85, 1/16 West of 1/4 Cor 33-34: Dug from a point at T. Hunter's measure (used 19.79 1/2 ch.) from the N-S fence @ 1/4 Cor 33-34 and 1.0 South of line from CIM at 1/4 Cor 32-33 to the point shot at 1/4 Cor 33-34 (2642.8 ± Note of S. 33-34) for 7' East and 10' South by 2' deep to first clay. found a limestone 2' x 4" x 13" x 22" lying flat with wood piece around the bottom but did not seem to be dug in at all. Only could be Hunter if he left a lot stick out of ground and it fell over. Also found porthole with wood piece still in it. Crockery broken around it and piece of limestone 3 1/2" x 4 1/2" x 12" lying down by it. Found another post stub 6' south of this. Seems to have old N-S fence here (See Drwg 25-105-11-6)

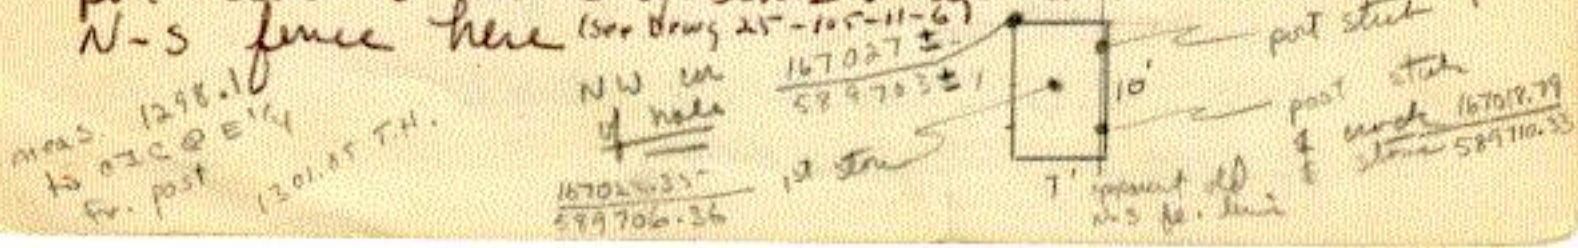

#513406 (2)

1/4 Cor 33-34 Elmira 105-11

7-2-85, 1/4 Cor 33-34: Dug under N-S fence from 3' South of traverse nail (nail 10' E of N-S fence); South for 11' by 2' west and 2½' ± East but did not find anything. Digging to cover line from CIM at the W1/4 Cor 33 where post hole (+ crocker) found at 1/10 West which came 12' ± South of nail and also T. Hunter projected measure (which would come approx 7½' South of nail) for S 33-34 to the fence at the 1/10 mark of 1/4 Cor 33-34. Condition not very good by fence. Found nothing.

8-29-85, 1/4 Cor. 33-34: Set CIC/p² on corner under the N-S fence and at double the dist. from Sec. Cor 24-28-33-34 (set this survey) over the E-W fence at the 1/10 South (a corner set by Hunter). Set survey marker sign & post 100 North.

RP: C.S.D. in W. side of pp# 2351 (up 7')

South 88.48

Spike and disc in N. side 3' twin white oak

ESE 53.72