/ 4-27-77 CIC Set

#526606 (1)

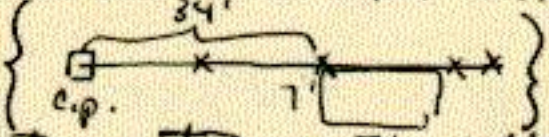
1/4 corner west 1/4 6 Orion 105-12.
east 1/4 1 Pleasant Grove 105-13.

4-1876 Hunter P301 no 296 L1 N mod.
Field BK 4 p. 142-143
Corner gone, B trees gone, land plowed. set corner M & L
40 00 BT- S 79° W 64 lks 10" burnt 64 lks. Post 1/4 post properly marked
1/16 west set stake 19.89 M & L. N 89° W

4-1876 Hunter P302 no 297 L6 N mod.
same data as above. Field BK 4 p. 144-145
1/16 east 19.16 chs 19.96 to center sec. 6. S 89° 30' W.
Field BK 4 p. 144-145
Shows mont at 40 1/2 40. 1/2 1/4 Set M+L (over)

5-1880 John Fraser P365 no 356 & Alex Predmar. Sec. = plan, Tur.

Corner gone, a stone shown by Predmar & John Campion a corner set by Hunter used but later found to be wrong so this survey Valuelles as to this corner

4-26-77 Dug 

7'x7' to cover an M&L location to the 7' different location of W 6-7 (See W 6-7). Found nothing.

4-27-77 Set a CIC/p^2 (down 1') M&L on the corner after setting W.6-7. Corner 4½' So of the E-W fence and 37' E of the fence So. R.P. CSD in So side of Nace post SW 39.00 SW corner of cement corner post (1' from top) WNW 37.38

1/4 CORNER WEST 1/4 6 ORION 105-12 #520606 (2)
EAST 1/4 1 PLEASANT GROVE 105-13

BALL, DEP. SUR.

Gov. Notes - Oct. 1857
North between 1 and 6
40.00 SET QUARTER POST
BR. OAK 10 IN. S60W 20 LKS
BR. OAK 10 IN. S68E 10 LKS