#52105

1 7-7-1962 set C I M orig stone on east side
5-11-1971 removed C I M - road well cut 40' ± 11-21-74 - reset C I M.
section corner. 10-11-14-15 Orion 105-12.
5-1877 Hunter P311 No 305 L11 Hopkins
found stake, well preserved by Mr Hopkins. set stone.
1/16 north set stone 6x7x32 M&L 19.96 N 1° W
— east set stake at 14.44 3/4 then 25.44 3/4 or
22 rods west of halfway.

5-1903 Armstrong P500 L11-12-13-14 Juske, Moore
F Halloran
set new corner by Meas 4 ways. stone 5x10x18.
Meas 39.81 east & west — 39.92 north & south
2627.46 40.02 2641.32 2634.72

7-1962 J Kerr B85-P60 L15 Rogstad
found corner stone over R P S.
see book 26 P5 L15 Meas south 2633.33 M&L.

spike or spud tele pole N 70° 30' W 142.15

½" rod 2' north cor past S 70 E 88.0

Corner lies 3' east of N-S fence in step pasture

no east-west lines — road lies south likely 15 rods.

5-11-1971 super road at corner cut up to 40' checked county

transit lines & made new additions


County Sta

above Lec 24 +84.44 — 2627.56

fence E&W 51 +12.0 — 2641

fence E 77 +53

" W 77 +51

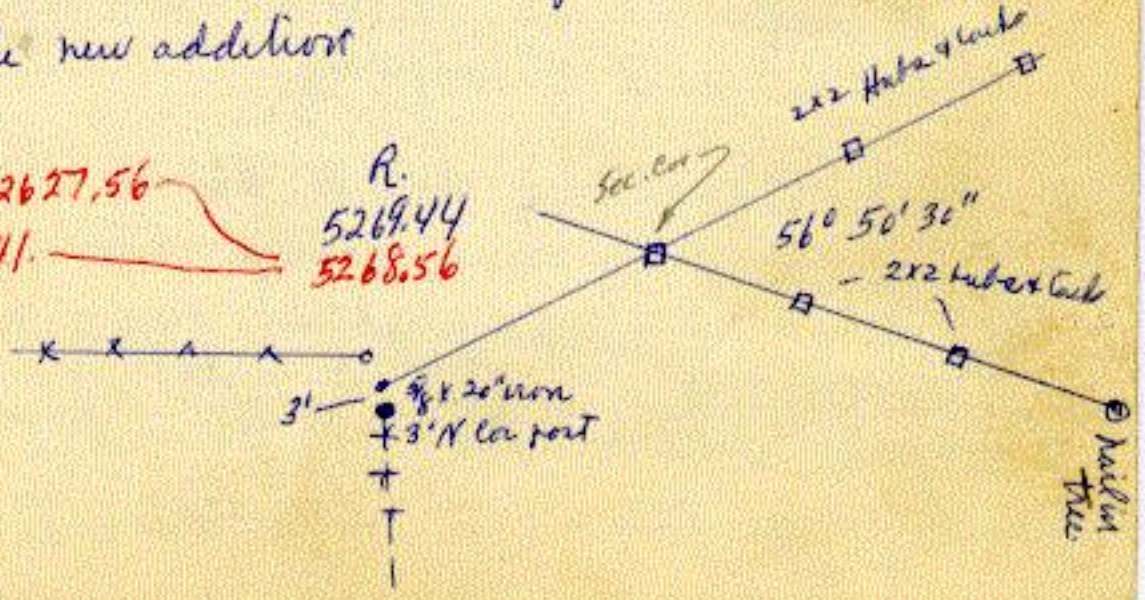

SECTION CORNER 10-11-14-15
NORTH BETWEEN SECTIONS 14 + 15 - VAR 10° 20' E #521105 (2)

GOV. NOTES - OCT 6, 1853 - WILLIAM JONES
80.00 chs SET POST CORNER TO SECT 10-11-14-15 ~~AS~~ AB
BR OAK 8 N 63 W 98
" " 10 N 70 E 302

11-21-1974 Set a C.I.M. over a ½" X 18" rod. Corner Now falls in west ditch C.R. # 7

R.P.'s

℄ of Concrete of C.R. #7	E.N.E.	53.7'
Corner Post (Co. Surv. Disc in West side)	North	3.50'
Corner Post (Co. Surv. Disc in east side)	South	56.23

5-16-97 FOUND CIM IN 4000 CONDITION.