X 6-11-1981 Set CIM #522805 (1)


section corner. 28-29-32-33 Orion 105-12.
9-1879 Hunter P363 No 354 L29 L Buck.
found old stake remains in road fill from slumps of
NW-SW & SE B T A
set stone 2½ x 5 x 15 with broken stone around
bottom to witness in case of removal for any reason.
1/16 west set stake, deep driven, M & L 19.95½. N88¾° E
with line running north to 1/16 cor N ¾° W.

4-1901 W Fraser P2B L29 T Bernard. J Baker.
found stone set as corner P363. Fellows.
1/16 west set stake & stone M & L 19.96. to iron ¼ corner.

over

Recent survey either Co Hwy Dept or J Kerr.
8 x 12 limestone with small drill hole on top in road.
tele pole LE 35.16
3rd fence post Le 65.61

1927 B 48 P13 Co H D.
found stone and stake
RP Cor FP SE 27.1 — Cor FP NE 33.4

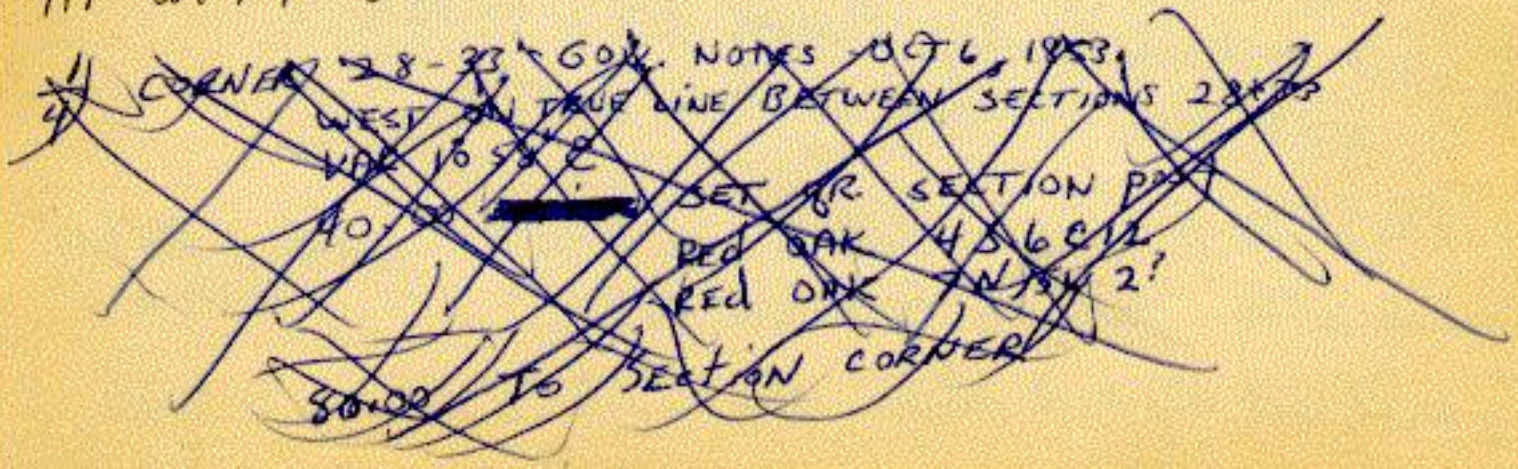

SECTION CORNER 28-29-32-33 ORION 105-12 (2)

North between sect. 32+33 - VAR. 12° 12' E #520805

COV. NOTES - OCT. 6, 1853 - WILLIAM JONES
80.00 chs SET POST CORNER TO SECT. 28-29-32-33

Red Oak 9 S 69 E 4L
" " 10 N 60 E 41
" " 10 N 47 W 42
" " 7 S 60½ W 46

6-10-81, 1/16 West: Dug and found an 8" x 10" x 2" limestone 3' deep. Stone appeared to have been broken off. Found stake hole on East side. Stone was dug into clay. Placed a ½" iron rod on the East side and surrounded the stone with crushed rock

6-17-81, 1/16 West: Set smooth rod, 5/8" conn. .15 East and .70 South of t.n and in & rd E and & main rd South

T.N. } 8.1 N
6.91 W

stone } 8.8 N
7.00 W

6-10-81, Sec. Cn 28-29-32-33: Dug and found 2½"x5"x15" limestone with smaller stones around it. The stone was on its side. Scraped and found remains of wooden stake in good condition. Cone was 3.5 deep and dug into clay. Set a 5/8"x1' iron in the stake hole and set stone over iron. Set a 3/4" iron on the West side and a 5/8" iron on the East side of the stone. Cone is in line with fences N & S and in the center of the road. and came .64E and 1.70 South of t.n.

T.N. { 6.92 N, 7.49 W } stake { N 8.64, W 8.33 }

6-11-81, Sec. Cn 28-29-32-33: Set a 20" CIM on a RR spike over the stake and stone found.

C.S.D. in east side of 1st post of fence running North — North 34.10

CSD in SE side of pp #1345 — NE 50.38

SECTION CORNER 28-29-32-33 ORION 105-12 (3)

11-15-94 FD CIM IN GOOD SHAPE IN EW TWP RD.

11-15-94, 1/16 WEST: FD 5/8" SMOOTH IRON IN GOOD SHAPE.

#522805