NOTE: See on finished corner file (#523604) ①

1/4 Corner South 1/4 36 Orion 105-12

5-1886 Hunter P 405 No. 394 S 36 L. Wyllis M. Morrison
Corner also Corner N.W Cor. 104-11 an iron set by Filmor County Surveyor. However Corner had been pulled & standing by fence. replaced iron monument by testimony of old settler J.R. Jones which placed it in line fence west and 3' east of end post of fence. Two B.T. left but would not place Corner in any one spot or anywhere near where it belongs.
- 1/16 east set temp. stake 20.17
- 1/16 north set marked stake M&L 20.13½ N 1½° W which lies 4.14 south of R.R. (likely E tracks)

11-1902 W. Fosses P 44 B Sec 36 Mrs. W. Farrier found iron stake as Corner. (indefinite meas. east.)


NE1 From South

Elm 14 S56E
B. Walnut 10 S6W
N S56W 390
180

Gov. Notes 1853 Sept.
West on south boundary of section 36
40.00 Set quarter section post.
Elm 24 in. N17W 317 lks.
Box Elder 10 in. N85W 90 lks.


NE1

8-3-78 Found 6"x6" topped twp iron monument (S.1, T104N, R12
1' NE of a cork frame used as a corner post
to fences West and North. Set a survey
marker sign and post 1' South. The monument
is .56N and .05E of the t.n.
RPs: CSD in E side of brace post N 11.1
P.K. in E. side of brace post NNE 32.0

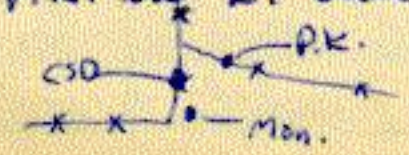

1/4 Corner South 1/4 36 Orion 105-12 (2)
#523604

We went to the S 1/4 Cr 36 Orio and set up a point 56 lks East of NE 1, 104-12, the first tie we got from the Filmore Co. Surveyor. We dug from a point 34½ East of NE 1 East for 4', North for 1½' and South 1½. We found bolting but conditions were good. If we have to go any further East we will soon be into cultivated field. We measured 32' West from NE 1 to the edge of the first branch of the slough which is 30 to 40 feet wide at this point (Count tie to S 1/4 Cr 36 is 1.65 chs.)

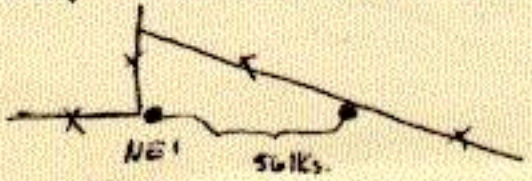

5-22-91 RCD

1955 Drawing 4-27A and 1983 Vince Fangman certificate show we gave since a location midway between section corners and on line from mon at NE Cor 1 to SE Cor 36

Found small comp error at SE Cor 36 which moves S1/4 36 location .56 N and .02 E. See Dwg 427A to set monument