X 4-18-1977 Co. Surv. found 2½"x15"x16" long Limestone Standing
Set CIM(16") with piece of angle iron on inside of Bottom of Ctr.

¼ corner 1-12 Pleas Grove 105-13 (#1)
#530104

7-1876 Hunter P301 no 296 & 1 N. Neal.
corner missing. both B trees standing, distances & bearings
would not agree. took mean of bearings and set marked stake.
18" blk. oak - N 73° W 41 lks = 27.00
15" bur oak & 66° E 55 lks. = 36.30
—1/16 east set stake N 88° 55' W
bearing of ¼ line north & 1° 10' E

1-1893 W Fraser P 504 no 474 & 12 Campion & Campbell.
found marked stake and both B trees P 301.
—west set stakes. 13.23⅓ - then 1.16 then 5.45⅔ to
stake assumed as 1/16 corner set N 8 L 19.85 —over—

9-2-69 J Kerr meas west from corner past assumed as probable line & corner of LE Col. 1 Pleas. Grove. dug some for 1/16 stake. meas to station 24+30. all lines stopped. a wooded precipitus gulley with no fences in any direction made any further work unessential abandoned line. Only way to reset corner means running line in early spring or late fall in cool dry weather. record last 19.78 N & L or 2611.0
- meas west 873.7 + 76.55 + 340.3 ft. 1310.1 or 25998
no fences in any direction, altho a property corner of long standing. if could be found the E-W line could be established as to its division point. Corner in roughest part of section.

1964 Mc Shie found vertical L stone likely washed that way on very steep slope. very extensive survey. see survey.

No Good =

1/4 Corner 1-12 Pleasant Grove 105-13 #2
#530104

4-18-77 Set CIM with a 12" piece of angle iron set on West side of the bottom of the 16" CIM. Rock prevented driving the angle iron under the CIM. Set the original stone on the N. side of the monument and piled limestone around the top of the monument. Stone 2½" x 15" wide at bottom x 16" long. Corner lies about 35' NW'ly of the ℄ of a ditch which runs NE-SW and about 100'-150' West of a 20" White Oak used as angle in fence running East and SW'ly


Blazed trees as follows:

8" Ironwood West about 30' (did not mean)
18" Elm North about 15' (did not mean)

14" Oak SE about 25' (did not mark)
6" Oak NE 9.44 (nail in SE side)

3" ironwood SE 6.5 (center of tree)

1/16th East (4-22-77) Dug to cover T. H.'s prorated location
From 1/4 cor 1-12
to the possible locations of E 1-12. Found nothing

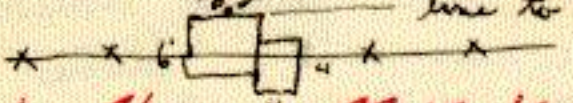

Good Notes M.K. Karrick 1951 EAST Randolph 1+12
40.00 Std temp 1/4 steel post
West on true line between Stds 1+12, 9°36'.
40.00 Std 1/4 steel post
Black oak 13" in W 55 W 30
Bur Oak 12" in S 50 E 5'