X 7/22/77 SET 1/2" IRON @ INTERSECTING 1/4 LINES (1)

#530509

1/4 corner Center 5 Pleas Grove 105-13.

7-1856 Hunter P 13 R 21 S 1/2 S 5. J. Brown.

J. Hartenbower

mad corner, set 1/16 each N & L 20.05 N 89 1/4 E

" 1/16 west — " 19.98 N 89 1/4 E

- meas south 40.03 N 12' W.

1960. Minn Hwy Dept Dw Val.

found iron set by co Hwy dept.

Elec power pole NE 74.5

" tele " SE 44.34. over.

8-6-69. J Kerr run exact E-W 1/4 line of sec 5. @ 40's at 1/4 5-6 and estimate at Center 5 missed by 4-5 N. 75 set short 5/8" rod in County black top 1' (12") from west edge black top apron or mat. Comes almost in line with Center corner post west RW but true line misses fence at railroad west by some 2 feet [line fell north of fence. Must have S 1/4 5 to set true center. ~~must have Sec Corner~~

Book # 35 Page 1
11-1921 C.H.D. Center of S.W. 1/4 section 5
a stone monument { From stone East to ℄ Elevator Track 408.4
{ From stone - East to ℄ Main Track 498.0

7-21-77 Dug 3' E-W centered on a point 14' East of Kerr rod on the West edge of blacktop. Dug 7' deep. Condition poor. Found nothing. Removed Kerr rod

#530509 (2)

¼ Corner Center 5 Pleasant Grove 105-13


7-22-77 Set ½" rod @ intersecting ¼ lines, 2' E of ℄ N-S road, and in line with fence W, & 1' N of ℄ of road East.

RPs CSD in pp #17432 NW 56.63

CSD in pp # 17431 NE 72.20

CSD in telephone pole stub w/box on N side SE 70.57

1/16th East

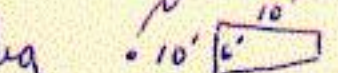

7-21-77 Dug 6' deep to clay. Found nothing. Dug to corner Hunter measure from E ¼ 5, Hunter measure from Center 5 and M&L. Hole centered N-S on E-W ¼ line of Section 5.

7-22-77 Set 18" Square pipe M+L. Corner came in

℄ E-W road & 14' East of ℄ of rd. Sr.
RP. CSD in power pole NNE 27.88

#530509 Center 5 (3)

1/16 Corner – Center of S.W. 1/4 Sec. 5-105-13

Simpson area

Co. H.D. 11-1921 BK. 35 P.1 indicates Stone mond. in place at this 1/16 Corner. 426+77.8

Co. H.D. 2-26-1921 BK 30 p.36

Sta. 426+77.8 P.I. Δ = 1°06' Left (stone) = (Stationing Runs West To East)

Ties: fe post N.NW (sta. 426+70) – 38.4
fe post N.E. 62.3

Sta. of Railroad (on curve) West (425+57)

Sta. of Railroad – East – 430+82 = (BK 35 P.1 = 430+82.2 & Main Track 431+75.8 House Track)

Sta. of Main Line RR East 431+71 with ∠ (37°36' = NE Quad ?)

NW cor. of Grocery Store – (433+00 – 33' RT)

Note by RWO.: evidently line run in Book 35 p.1 was farther North than line run in Book 30 p.36 although both books call for Stone in place

angle with RR Tracks in Book 30 says 37°36' → probably wrong

" " in Book 174 " 35°32' = could be right

(over)

Co. H.D. 7-1945 Field Bk. 174 p. 1+2 - Topog. p. 41-49

13+79.74 (from East) PI $\Delta = 10°06'$ RT

60 D nail shown as PI (side note says: Stone mons. is .8 west from True 90°

Ties: To 60 D nail

So. To Tree - 57.97 (Sta 13+80 ±)

S.E. To NE Cor. House - 64.68'

9+68.2 - Tangent of Railroad (Track #2) 35°38' ∠ NE Quad

8+79.0 - " main line" (Track #1 35°32' or 52' - NE Quad

0+95.43 - PI. (East side Simpson @ Co. Rd #1)

Co. H D. 1950 BK 176 p. 3-4

0+95.43 PI. (apparently same pt. as above)

Ties: nail & disc in 24" Elm (NE ?) 88.45 (could be NW) Book drawing not clear

nail in (Tree) (East?) 73.67 (could be North)

nail & disc in Tel. p. - (S.E.)? 35.84 (could be NE)

13+79.74 PI. $\Delta = 1°06'$ RT

Ties. 16" Cottonwood Tree - (NW)? 39.0 (could be NE)

10" Cedar Tree - N.E.? 38.55 (could be SE)

#530509 Center5 (4)

1/16 Cor. - Center of S.W.1/4 Sec. 5 - 105-13 (Simpson)

Co. H.D. 12-1973 Book 382 p. 2 (Topog. p. 22)

100+00 = ℄ intersection Co. Rds 1 & 16

note says: 3/4" re-rod 8-10-1978

113+21.10 P.I. Δ 1°02' RT Note says: 3/4" re-rod = 8-10-1978

108+19 } ℄ Crosses rails of Railroad
108+28 }

109+09 } ℄ Crosses rails.
109+17 }

114+46 } ℄ Crosses rails.
114+51 }

9/89 FD 1/2" ROD DOWN IN BLACKTOP, 3' WEST
TO ℄ OF C.R. #1

Section 5 Pleasant Corner 105-13

— Corners in Simpson —

1. Intersection of Church St. and Rochester St.
4-26-76 Dug for stone on record in original plat. Found road cut. 3' to 4' of fill on clay. Found nothing.

2. Intersection of Rochester St. and St. on S. edge of Simpson
4-27-76 Dug 5' deep. Found nothing. Road cut to clay and backfilled.

3. Intersection Brown St. and St. on S. edge of Simpson
4-27-76 Found 3" x 8" x 12" limestone (shotty) 3½' deep in original black soil. Set scrap iron around stone and another piece of stone along side
Drove 1½" x 30" pipe over
R.P.'s: SW corner of stone foundation of house NE 63.6
Punch hole S. end 18" CMP in Rd. E SE 28.10

Punch hole N. end 18" CMP in Rd. E NE 30.13
Punch hole S. end 30" CMP in Rd. W SW 60.08
Punch mark N end 30" CMP in Rd W NW 61.46

Intersection Brown St. and Church St.

4-27-76 Dug at platted measure from stone S for recorded stone. Found nothing. Street cut. Measure came in ℄ E-W St.

7-20-77 Intersection of Rochester St. and the Street on the So side of Simpson.

Set a ½" x 2' rod at plat measure (366') from the stone found to West in 1976 and such that the line from the stone to the rod is perpendicular to the line from the rod to the N¼ Cor 5 (Co. location) The Rod is 1.3 E of ℄ Co. Rd #1 and is E of Street West.