1 9-29-71 found old corner post stub believed to be 1886 corner.
4-26-73 set 1¼ x 5' pipe 2' E of cedar stake found (final ck)

¼ corner center 9 P Pleasant Grove 105-13

#530909 (1)

9-1876 Hunter P 305 no 300 & 9 L Bennett.
found stake set as center Survey no 8.
– 1/16 south set stake M & L 19.88 N 1° W (cedar stake)
– line east from above 1/16 40.40 1312.08 N 89° 50' E

Elec Card 2 for 1345

9-1886 Hunter P 415 no 404 & 9 L Bennett & Leach
found remains stake P 305. set new cedar stake.
– 1/16 west set cedar stake M & L 20.05 1323.3 N 89 3/4 E
– 1/16 south found stake set P 305 M & L 19.88 1312.08.
– center road line or one edge road line 5.00 north of above 1/16 then angles to 1/16 west of center at bearing & S 43½° E

2666.4

(over)

5-1900 Robt Fraser P 676 No 601 & 9 Ed Campion.
found cedar stake set. P 415. previously set by Hunter
at True intersection lines.


1/16 east set stake M & L 20.13 1/4 [1328.75'

1/16 center NE 1/4 9. set stake M & L 19.81 3/4 on N-S 1/16 line
1307.96

9-29-71 co surv. ran traverse from S. Kerr and east
to corner post at center 9 - later found 1/4 8-9 to be .2 S
and 4.1 E of rod. - Traverse on card #2. found stub of very
old corner post. at 2646.6. E 2.2 S using metal
base line 1315.9. (cornfield cutting crew of corner post)
- indicates line would meas. 2642.5 and orig line east
would be slightly north of line R 2646.3?

9-29-71 traverse from 1/8 8-9 east to center 9. (2)

Center 9. Pl. Lr 105-13.
#530909

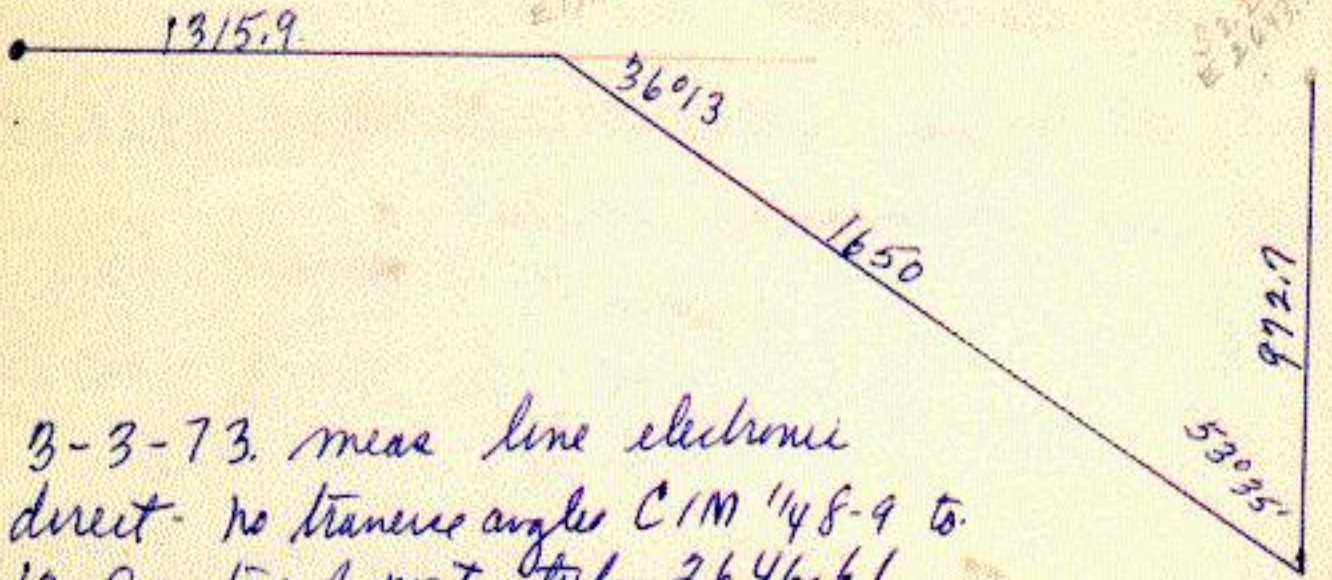

3-3-73. meas line electronic direct- no traverse angles C/M 1/4 8-9 to. 120 Dm top of post stub 2646.61

Center 9 Pl. Gr. ⊕

5-1874. Hunter P248 no 249. S 9 J. Whitney found stake set as center section set in survey no 8. Page 5 tested SW Blue stake standing.
Meas west set 1/16 temp. stake Midway 20.08 1325.28
Meas North. set stake M&L 19.70 1300.2
set prop corner. 1/4 way from 1/4 4-9. (1½x17x22) stone to 1/16 South. 4.92½ 325.05 then 14.77½ 975.15 total ½ mile betw center 9 and 1/4 4-9 2600.4

5-1856 Hunter P5 no 8 NE 1/4 17 - SE 1/4 8 - SW 1/4 9 - NW 1/4
Meas center 9 west 20.02 M&L 1321.32.
" South 19.79 M&L 1306.14
" meas above 1/16 west 20.07 M&L 1324.62

#530909

Card # 2. Center 9. Pleasant Shore 105-13.

3

3-5-73 found post stub 2'±
raw electronic traverse direct from C/M at 1/4 4-9.
south thru open area. final computations later.
4-18-73 ran direct careful offset line 12' south of 1/4 8-9
over 120 Dia post at Center 9 (then accepted corner).
- line fell at least 14' south of corner post & properly fence at
1/16 east of Center 9. R 1328.75 R Fraser. 5-1901 P676.
- line fell about. 1313.2 N of 1/16 rod found in road south or 1325.2.
Record of this Hunter 1315.38 R Fraser 1316.5 Shore F 2620.
- line fell ± 663.2 S of corner post North of fence E-W-N. M&L.
or 651.2. R. J Kerr 1917 659 to stake found ? found old post stub
this shows line raan should have terminated 9'± further south (over)

4-19-73 easily found post mrked red cedar stake
set by Hunter 9-1886. P415 survey Sec 9.
stake corner .45 west and 4.65 S. of. 120 Dia post stub.
which surely proves itself by terminable of lines run 4-18-73
- 1/16 east really off (mrked corner on cultivated field.
at least 15.5 east of POT nail and about 5' north for true line ±
Chances of this stake in level cult field is zero - of surviving.
- entire area where 1/4 9-10 would come dug & plowed to clear
clay. Corner would come about 2.7 north of nail & iron post
4.65 x 2 = 9.3 pos. 12.0 S. - 9.3 = 2.7 corner N of error line random
Could set on line later re-set N 3-4-9-10 Found iron set by Chas Ann 1/16
4-26 set 1 1/4" x 5' pipe .2' east of cedar stake. at center of
found mrks south now to CIM 26 18.4 elect.
place center 9 on exact direct line to 1/4 9-16 as set. a little
east of possible stake found. 4-25-73.

#530909 (4)

1/4 Corner Center 9 Pleasant Grove 10S-1E

May, 1856 Thos. Hunter Shows Center Sec. with two Bearing Trees (N 86° W 410 links) & (S 59¼° W 165 links),

1/16 west 20.02 chs. M&L to 1/4 Post.

1/16 South 19.79 chs. M&L to 1/4 Post

Center of S.W. 1/4 Meas. 20.07 chs. East & West. and 19.85 chs. North.