1 5-30-1972 set drag tooth from line and meas S. (1)
#531004

1/4 corner 10-15 Pleas Grove 105-13.
6-1886 Hunter P410 no 399 S15 H Burgess, R Folsom.
found old stake lying on ground and stub in ground.
tested stumps of 8 trees. set new stake with old stake
and iron stake by its side.
1/16 west set stone with stake by side N0L 19.94 links 1316.37 line south.


2-1892 Thos Fraser P470 no 451 S10 J Goodman, J Campion.
found iron stake in rock on SW side of hill by Hunter.
used to set center 10 only. No meas.

1-1894 W Fraser P543 no 504 S15 John Clark est.
found iron stake P470.

(over)

set stone 2 x 12 x 20 M & L 19.77 at 1/16 cor south.
BT 6" Hickory N 81½ E 18 lks. 1304.82

1/16 center NE 1/4 15 set stake M & L 19.96 on E-W 1/16 line. =1317.36

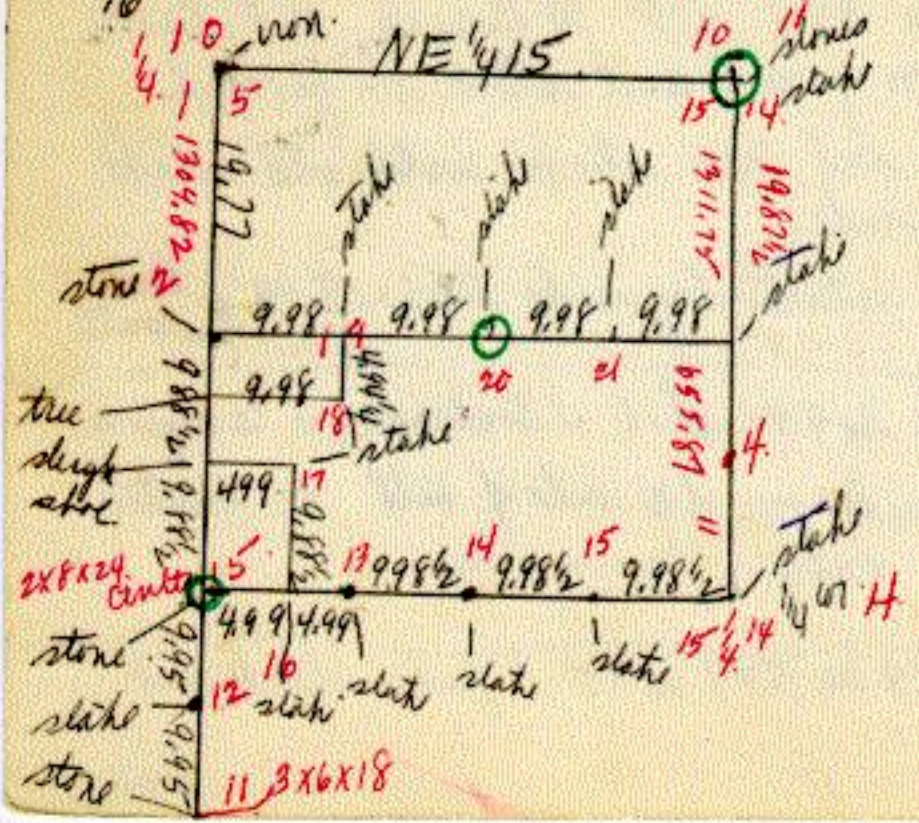

19-20-21 stakes on line

17-18 stakes on line.

13-N-15-16 " " " betw I & H.

10 - stone & stake SW (9.95

11 stone 3x6x18
12" Wk. S63E 14L. 9.24'

12 stake.

7-8-9 stakes betw F & G.

6-6 stakes line

5 tree as corner.

4 - Wk stake M&L 3 & H.

3 iron M & L A & H.

2 stone & stake M&L 1-B 2x12x20

Card # 2 1/4 10-15 Pleasant Shore 105-13 (2)

1-17-1876 Hunters fieldbook no [4] L10 for C C Wilcox

"5" a point north for wood lot line west still prop line #531004

at 8.75 577.5' A hickory tree to this point

3" ash N 42½ E 8 lks. 5.28' Market B T.

at root and other unreadable markings.

also prop line east still used at 10 chs 660'

5-12-72 Mark from NE 15 west

- found iron in fence at 657 ± very rugged & brushy.
- found 4"x4" post at 1226 ±
- found small stone N side fence at 1316.65
- found fence south at 1482 defunct prop line
- found fence north at 1650.
- found 1"x16" iron at 2620.2

over

Meas west to stone in flood plain 9-10-15-16.
Meas uncertain line meander searched extensively for.
1/16 stone between 1/4 10-15 and 9-10-15-16. set 6-1886.
M&L. 19.94 1/2. 1316.37 this area quite steep & washed.
- 5-17-72 ran N-S 1/4 line 15. from C1M set at 1/4 15-22
where position stone found. 5-17-72 over position & stone
at Center

5-1921 Chas Armstrong book B page 53
shows iron as 1/4 corner. with B.T.s
N 82 1/2 E 26 lks. 17.16 - N 6 1/2 W 23 lks. 15.18
N 0° 40' W. to Center 10. (see center 10).

Jan, 1858 T. Hunter Pg. 46 No. 68 shows 1/4 Post.
Meas North 10 chs, then 20 ch, then 10 chs. to Cen Sec 10
Meas East 10 chs. then 10 chs. then 20 chs. to Sec Cor
(See survey for breakdown & B.T.s to the Corners.).

Card # 3 1/4 10-15 Pleasant Grove 105-13. (3)

5-17-72. Cont elect line from. 1/4 15-22 on 10' ⓔE over center 15 on 10' ⓔE. to E-W fence at 1/4 10-15. #S 31004
- found meas to be 1328 not 1304.82 record.
- set drag tooth in rock hillside 21.8 S of Zag nail

5-30-72. reset iron drag tooth on exact line from south 1,51 N or 2809.64 north of center 15, believe this final corner unless electronic traverse line taken and used super dip needle to search again for iron very likely removed
- drag tooth 11.25 west of 1" pipe found. about 22+' south.
1,4 west of eye ball line of pole line south.
8.4 SW to center 8" oak stump. (a sort of hidden corner)

Gov't Works M.C Karrick 1851 Ernst Ranlem 10015
40.00 Std temp 1/4 Std post
West on line between Std 10015
40.06 Std 1/4 Std post V to 15'

Aspen 7 W.C. W 72
" " 7 585 E 27

1-22-85 McGhie found drag tooth. Measured 2629.84
to SE Cor 10. Surveyed SE 1/4 SE 1/4 SE 1/4 Sec 10